

Name Mary Casey

Service No. 61

Address 91 Reed Street

^{lot}
16 & 17 BLOCK B REED ST.

Location

Kind of Pipe

Size 6"

Size of Main 8"

~~REPAIR WORK~~ New Service

Location Comm 6-16-61

Date	Material	Amount	Total	Date	Amount
6-7-61	Labor	95.76		5-31-61	Deposit 200.00
	10% O.H.	9.58	105.34	6-19-61	Paid by WPC# 20 16 26
61'	6" Transite pipe @.78		47.58		
1	6" Transite 90° Elbow		5.40		
4 1/2	Ton 1 1/2 Stone @1.50		6.37		
4	Ton Bank Gravel @.85		3.40		
4	Hrs. Town Shovel @6.50		26.00		
2	Hrs. Trucking @3.00		6.00		
1	Hr. Tractor @2.00		2.00		
	23 x 3 Patch		23.00		
			<u>225.09</u>		
	Labor			1-17-76	Solids
				8-1-87	S. B.
				6-19-61	Bills-out 9.83

TOWN OF LEXINGTON—DEPT. OF PUBLIC WORKS

SEWER DIVISION

DATE.....

NO.


The undersigned applies for the construction of a particular sewer connecting No.....
 Street and hereby agrees to comply with the Rules and Regulations governing the construction and use of Particular
 Sewers, as now or at any future time established by the Board of Selectmen.

Am't of estimate \$.....

Am't Paid \$.....

..... Owner

Sketch of Service Here

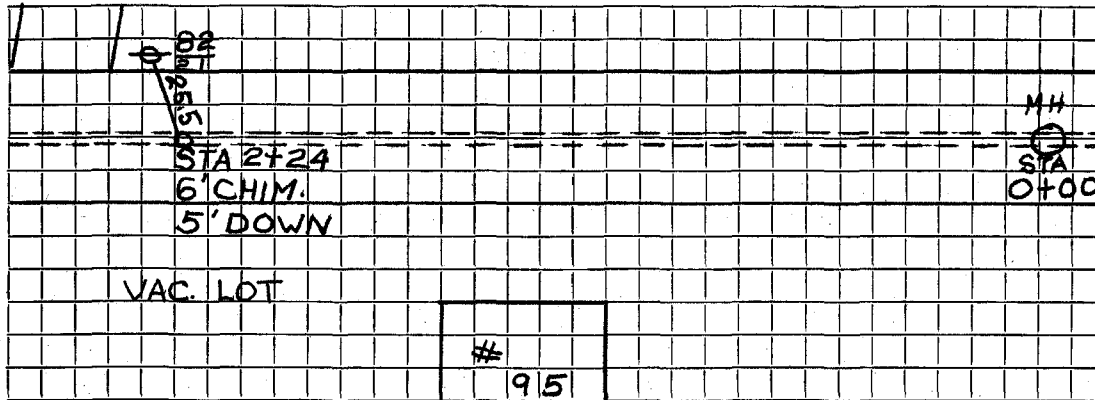

Connection made in..... Street.

Work completed.....19..

Remarks: