

Name Eugene Delfino

Service No. 26

Address 94 Reed Street

94 Reed Street

Location

AUG 6 1979

Kind of Pipe

Size 6"

Size of Main 8"

~~Material~~ New Service

Lexington Sewerage #3385

Location


Date	Material	Amount	Total	Date	Amount
5-17-79	43' 6" Transite pipe			5-7-79	280.00
	10' 4" Cast Iron pipe			5-6-79	92.67
5/10/79	Labor	68.00			187.33
	10% O.H.	6.80			
	20' 6" Transite @ 1/91	38.20			
	1 5' X 6" Nipple @ 1.75	8.75			
	1 6" X 45 Elbow	6.26			
	2 6" Collars @ 2.25	4.50			
	1½ Hrs. Trucking @ 3.00	4.50			
	2 Hrs. Backhoe @ 6.50	13.00			
	Hot Top 4' X 14'	37.32			
		\$ 187.33			

DATE _____

TOWN OF LEXINGTON — BOARD OF PUBLIC WORKS

SEWER DIVISION

Sketch of Service Here **94**

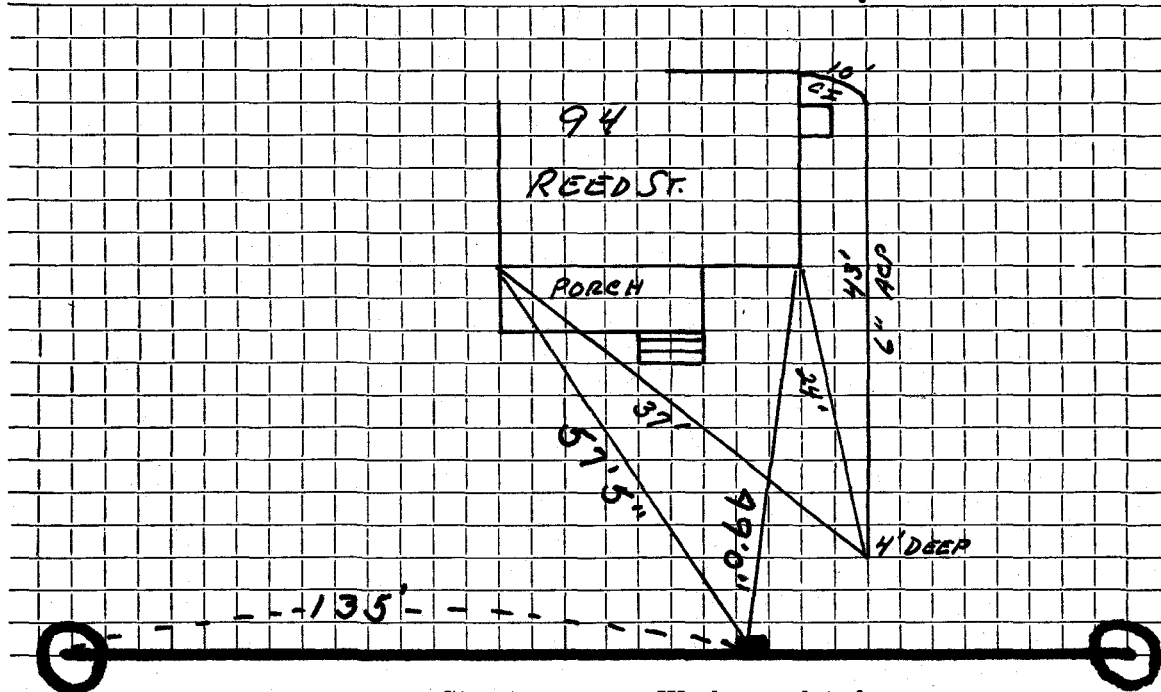

Connection made in Street. Work completed

Remarks:

.....

.....