


DATE 11/4/2019

TOWN OF LEXINGTON — BOARD OF PUBLIC WORKS
SEWER DIVISION

Sketch of Service Here

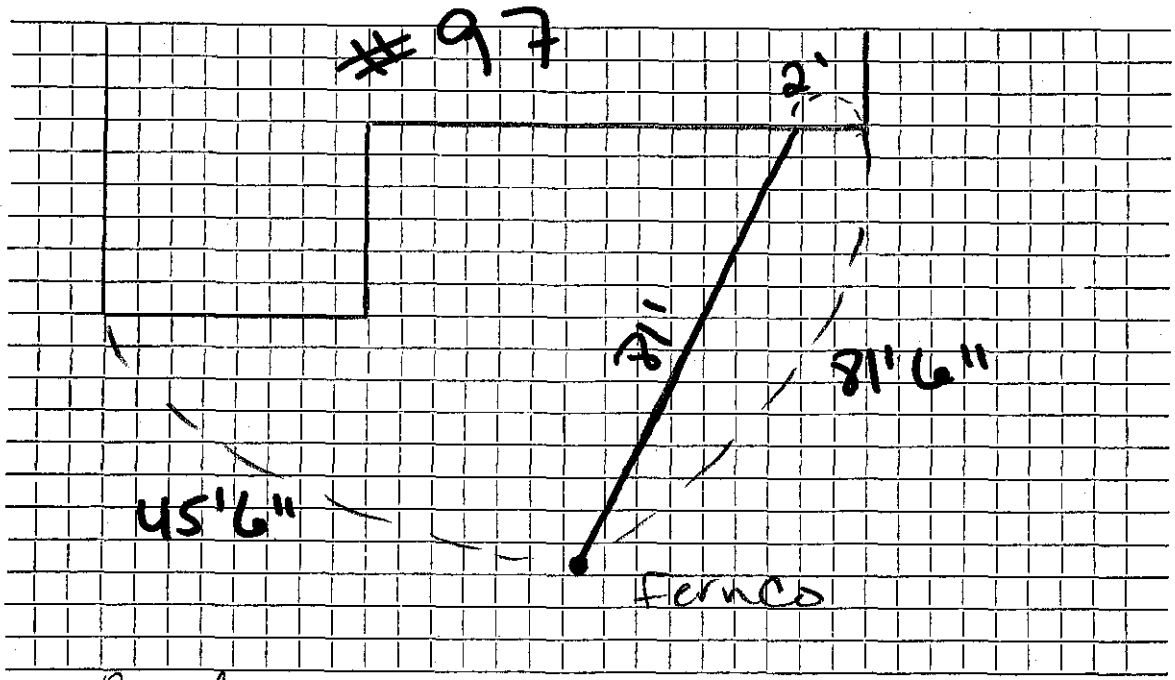

Connection made in Reed Street. Work completed

Remarks:
.....
.....