

Name

Service No.

Address

VAC. LOT 16 BLOCK 17 REED ST

Location

Kind of Pipe

Size 6"

Size of Main 8"

Repair—Renewal—New Service

Location

Date

Material

Amount

Total

Date

Amount

Labor

# TOWN OF LEXINGTON—DEPT. OF PUBLIC WORKS

## SEWER DIVISION

DATE.....

NO. ....


The undersigned applies for the construction of a particular sewer connecting No..... Street and hereby agrees to comply with the Rules and Regulations governing the construction and use of Particular Sewers, as now or at any future time established by the Board of Selectmen.

Am't of estimate \$.....

Am't Paid \$.....

..... Owner

**Sketch of Service Here**

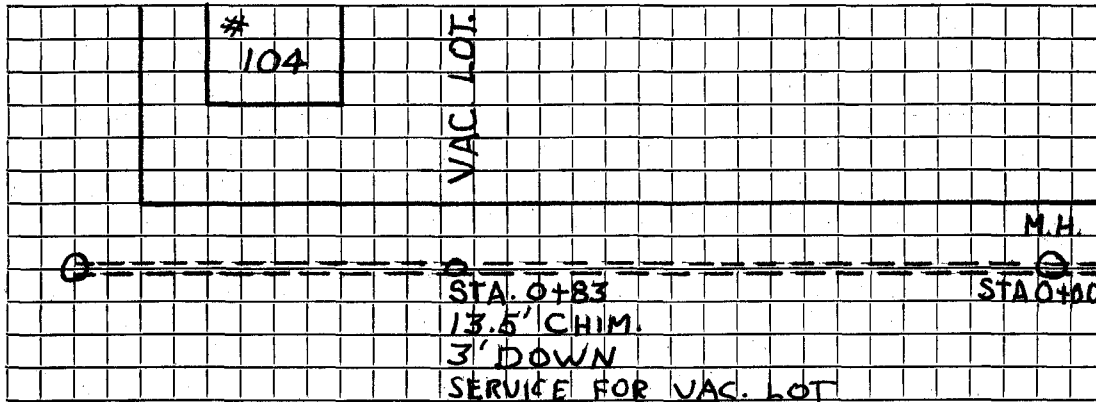

Connection made in..... Street.

Work completed.....19..

Remarks: