

Name

Service No.

Address 11 REVERE ST

UTICUN

Location

Kind of Pipe

Size

Size of Main

Repair ~~Renewal~~ New Service

Location

Date

Material

Amount

Total

Date

Amount

5/20/12

6" SDR

6" CLEAN OUT

.6' CAP


.6" SDR RISK 1/2

.6' TEE W/2"

DATE 5/10/2012

TOWN OF LEXINGTON — BOARD OF PUBLIC WORKS
SEWER DIVISION

Sketch of Service Here

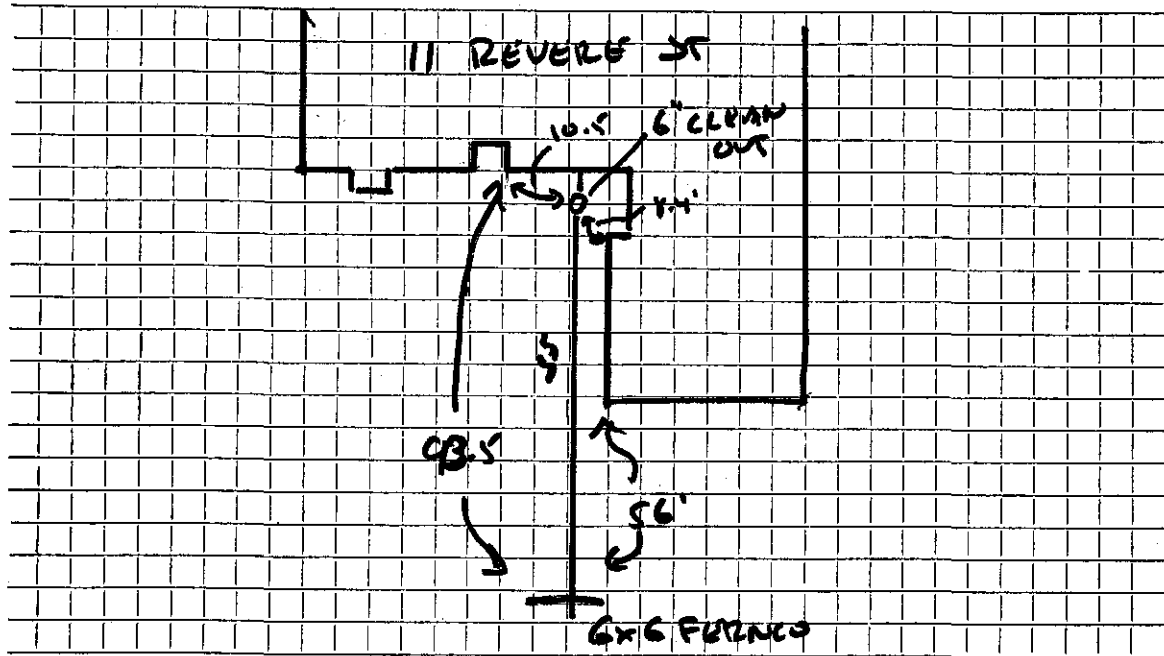

Connection made in REVERE Street. Work completed UTICON

Remarks:

.....

.....