
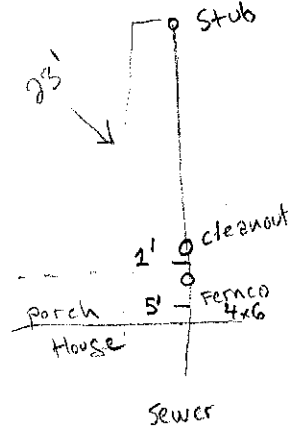


DATE 2/8/17

TOWN OF LEXINGTON — BOARD OF PUBLIC WORKS
SEWER DIVISION

Sketch of Service Here

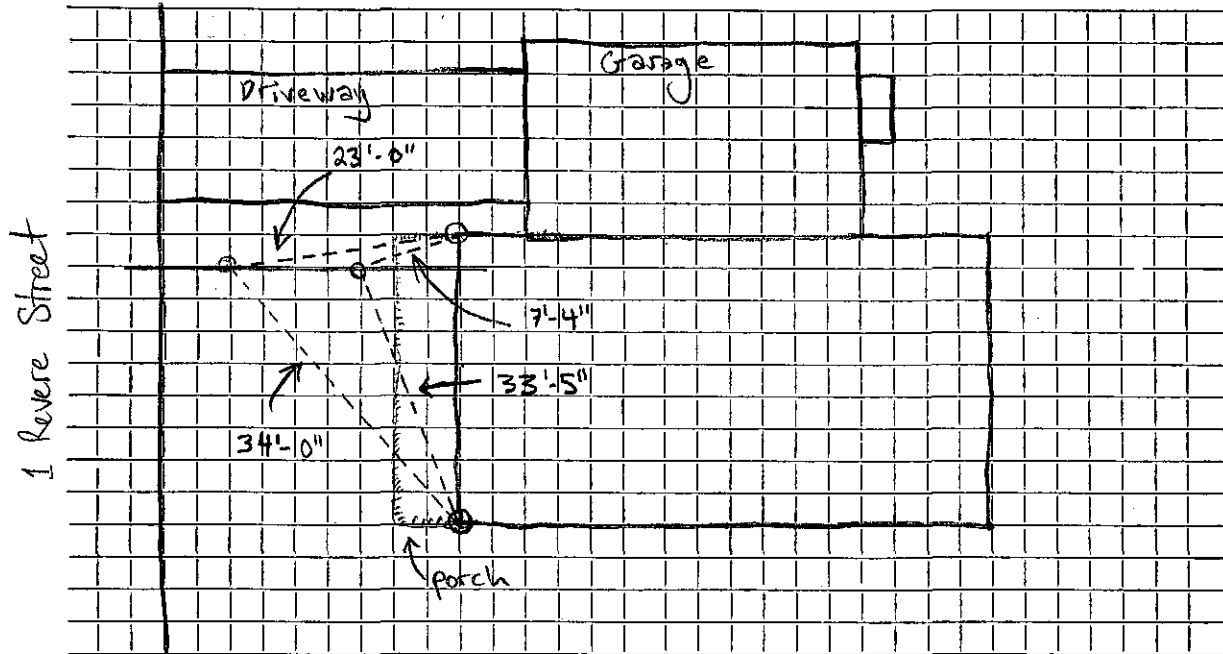

Connection made in 1 Revere Street Street. Work completed

Remarks: