


SEWER SERVICE
TOWN OF LEXINGTON
10 Revere Street

DATE _____

BOARD OF PUBLIC WORKS
SEWER DIVISION.

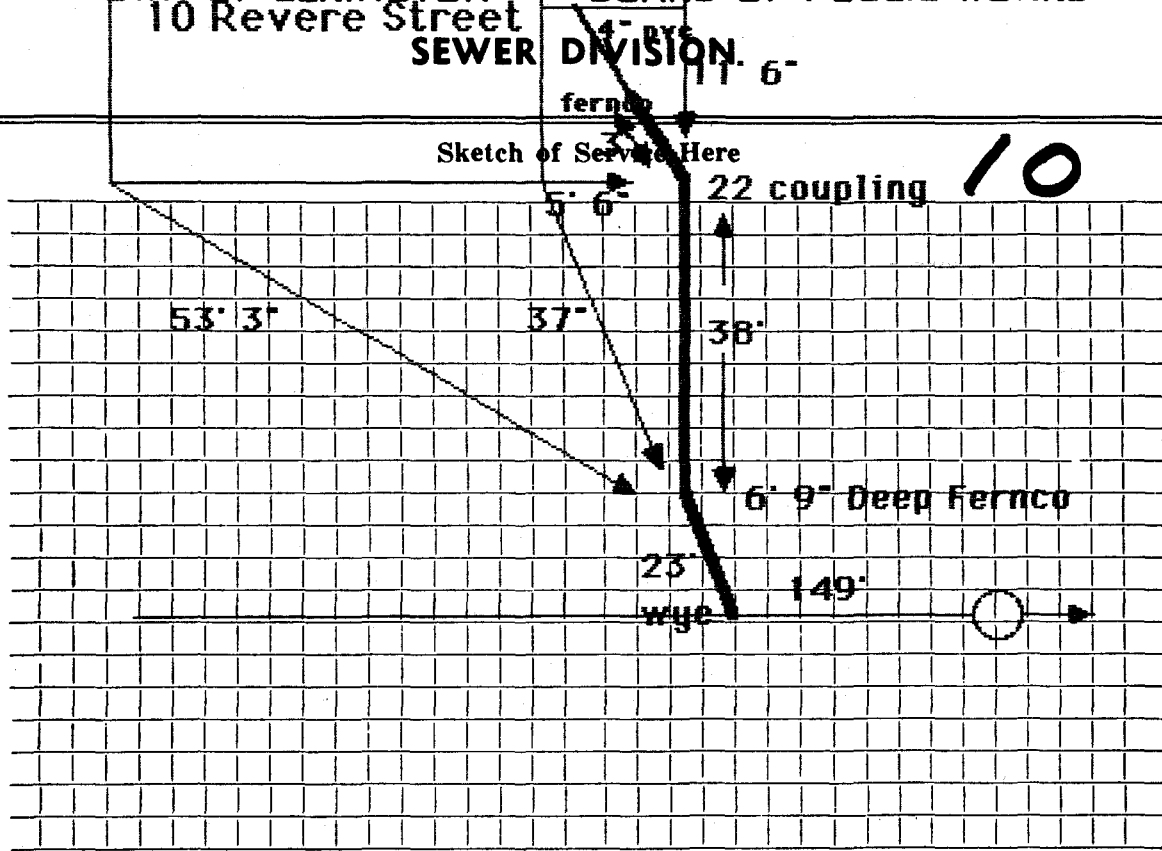

Connection made in Street. Work completed

Remarks:

.....

.....