

Name Philip B. Parsons

Service No. 147

Address #18 REVERE ST.

JUN 18 1973

18 Revere Street

Location

Kind of Pipe

Size 6"

Size of Main 8"

~~REPAIR~~ New Service Trebino #2168

Location


Date	Material	Amount	Total	Date	Amount
9/29/72	23.0 A.C. @ 9.00	\$207.00		9-28-72	207 00
				Deposit	

DATE _____

TOWN OF LEXINGTON — BOARD OF PUBLIC WORKS

SEWER DIVISION

Sketch of Service Here

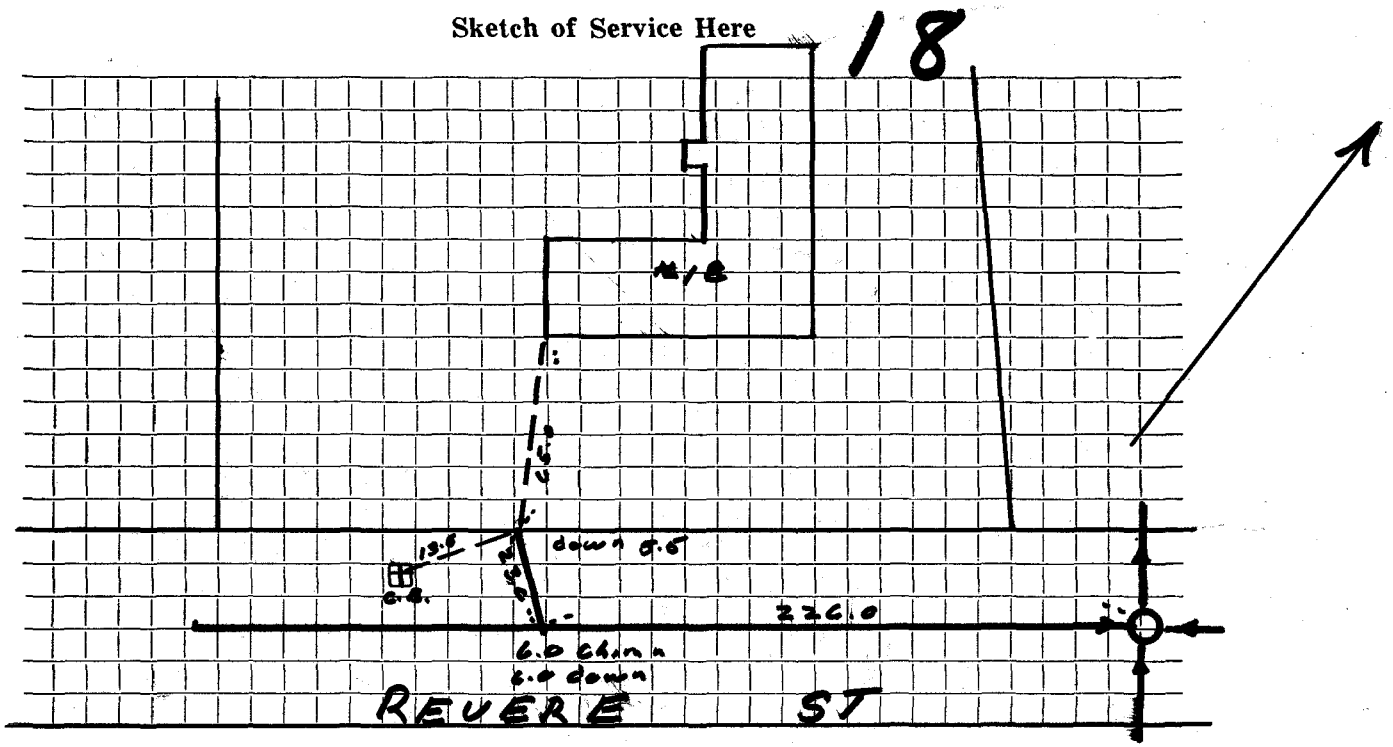

Connection made in Street. Work completed

Remarks:
.....
.....