


DATE 5/7/20

TOWN OF LEXINGTON — BOARD OF PUBLIC WORKS
SEWER DIVISION

Sketch of Service Here

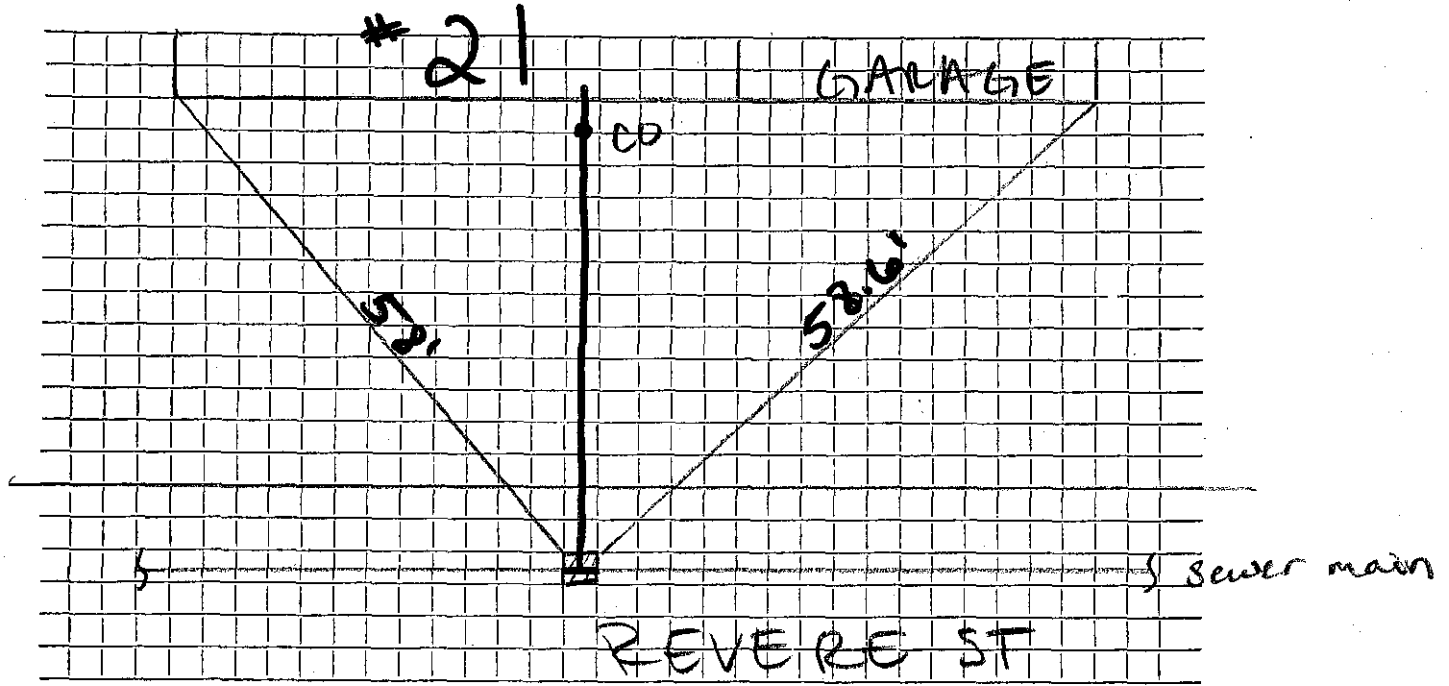

Connection made in Revere Street. Work completed

Remarks:
.....
.....