

Name Brian Connolly

Service No. 42

Address #22 REVERE ST.

22 Revere

Location

Kind of Pipe A.C.

Size 6"

Size of Main 8"

~~Repair/Renewal~~ New Service Arlex Oil #3848

Location OCT 31 1983


Date	Material	Amount	Total	Date	Amount
8/22	72 28' A.C. @ \$9.00	\$207.00		9-26-83	Deposit 207.00
10/3/83	39' x 6" P.V.C.				
	1 6" Wye				
	1 22½° Elbow				
	1 45° Elbow				
	1 6" P.V.C. Plug				
	1 6" x 4" Donut				
	1 6" P.V.C. x A.C.P. Adaptor				
10-16-92	12' 6" PVC				
	2 6" PVC to AC ADP FERPCO'S				
	2 45° Bends PVC				

DATE _____

TOWN OF LEXINGTON — BOARD OF PUBLIC WORKS

SEWER DIVISION

Sketch of Service Here

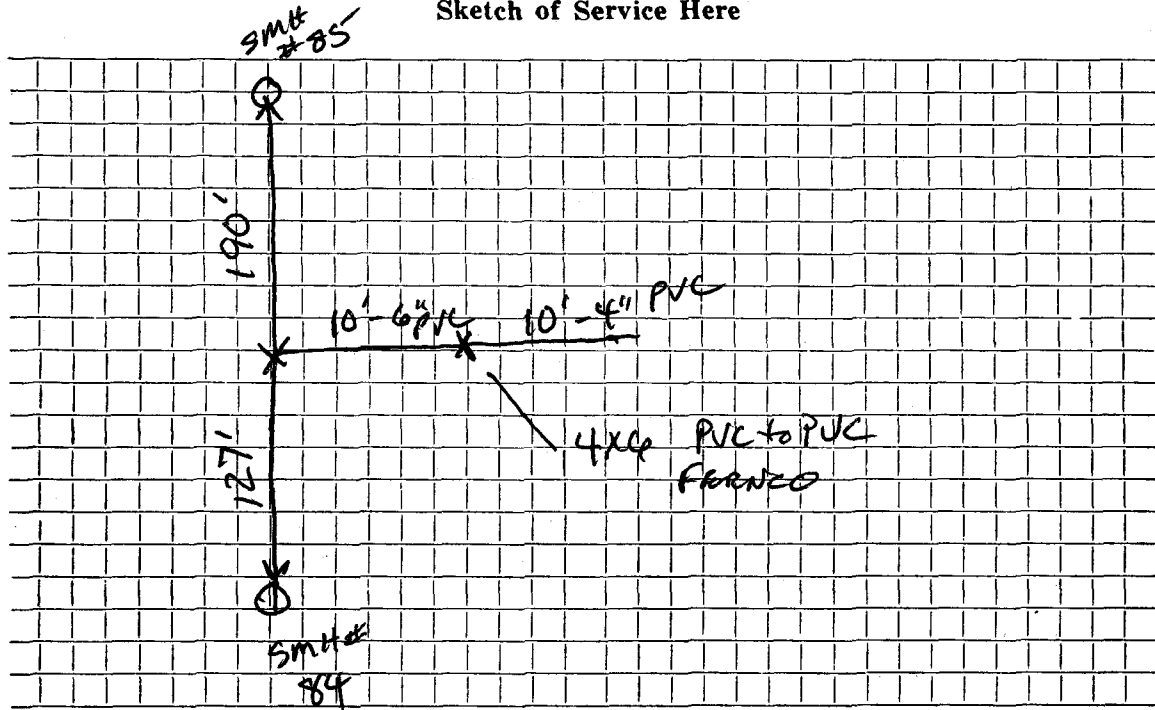


Connection made in _____ Street. Work completed _____
Remarks: SERVICE of BACK of house to EASEMENT

DATE _____

TOWN OF LEXINGTON — BOARD OF PUBLIC WORKS
SEWER DIVISION

Sketch of Service Here **22**

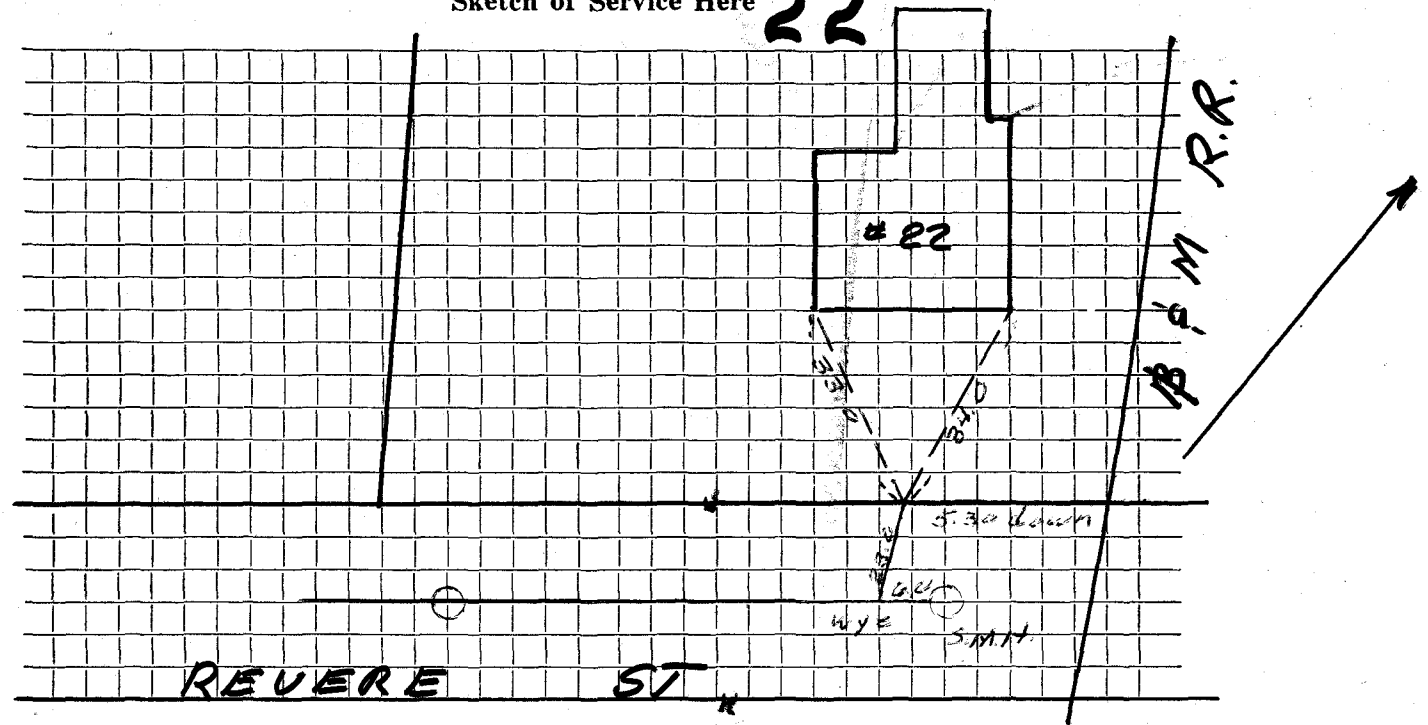

Connection made in Street. Work completed

Remarks:
.....
.....