




DATE \_\_\_\_\_

TOWN OF LEXINGTON — BOARD OF PUBLIC WORKS  
SEWER DIVISION

Sketch of Service Here

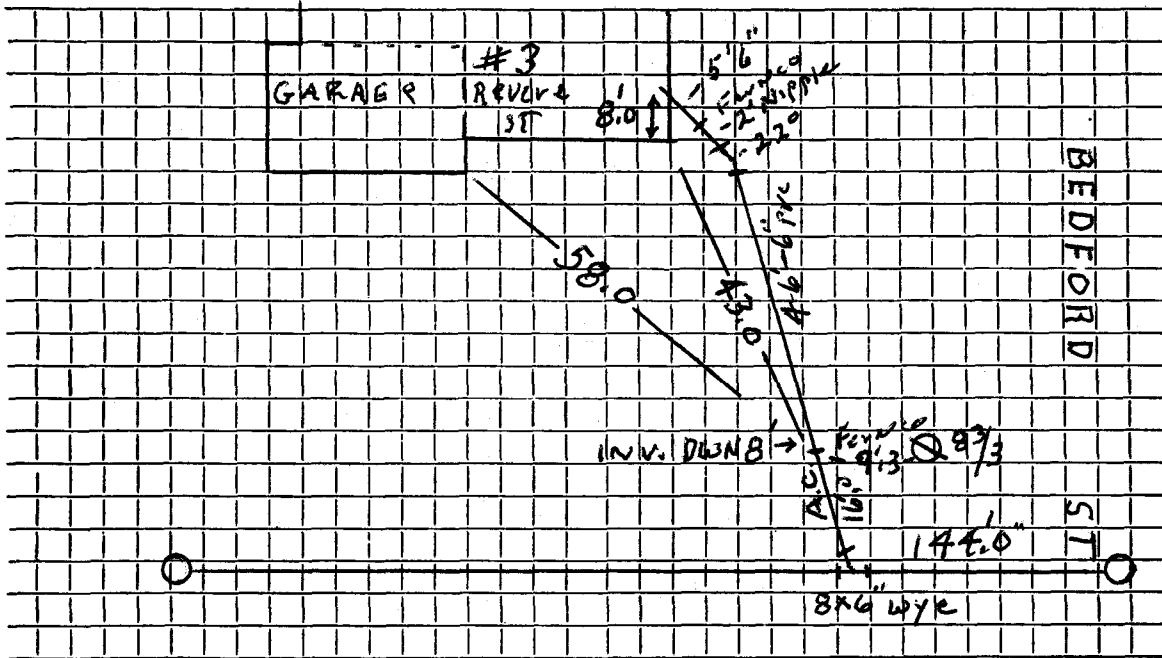

Connection made in Reverse S.T. Street. Work completed 6/5/06 J. McLaughlin

Remarks: Old Service. Land Shows. 14' Trans. IN S.T. 1964