

Name Lawrence Redgate

Service No. 141

Address 30 Revere Street

30 Revere Street

Location

Kind of Pipe

Size 6"

Size of Main 8"

Repair—Renewal—New Service

Location Comm 11-13-61


Date	Material	Amount	Total	Date	Amount
10/17/61	Labor	83.63	83 63	10-6-61	300 00
	10% O.H.		8 36	11-13-61	69 33
			91 99		230 67
84	6" Transite pipe @ .78		65 52		
1	8x6 Service Saddle		5 65		
1	6" 90° Transite Elbow		5 40		
1	6" 22½° Transite Bend		6 21		
1	6" Duplex Adapter		1 90		
3	Hrs. Town Shovel @ 6.50		19 50		
2	Hrs. Trucking @ 3.00		6 00		
	20 X 4 Patch		26.50		
	2 X 3 Sidewalk		2 00		
			230.67		

DATE _____

TOWN OF LEXINGTON — BOARD OF PUBLIC WORKS
SEWER DIVISION

Sketch of Service Here

30

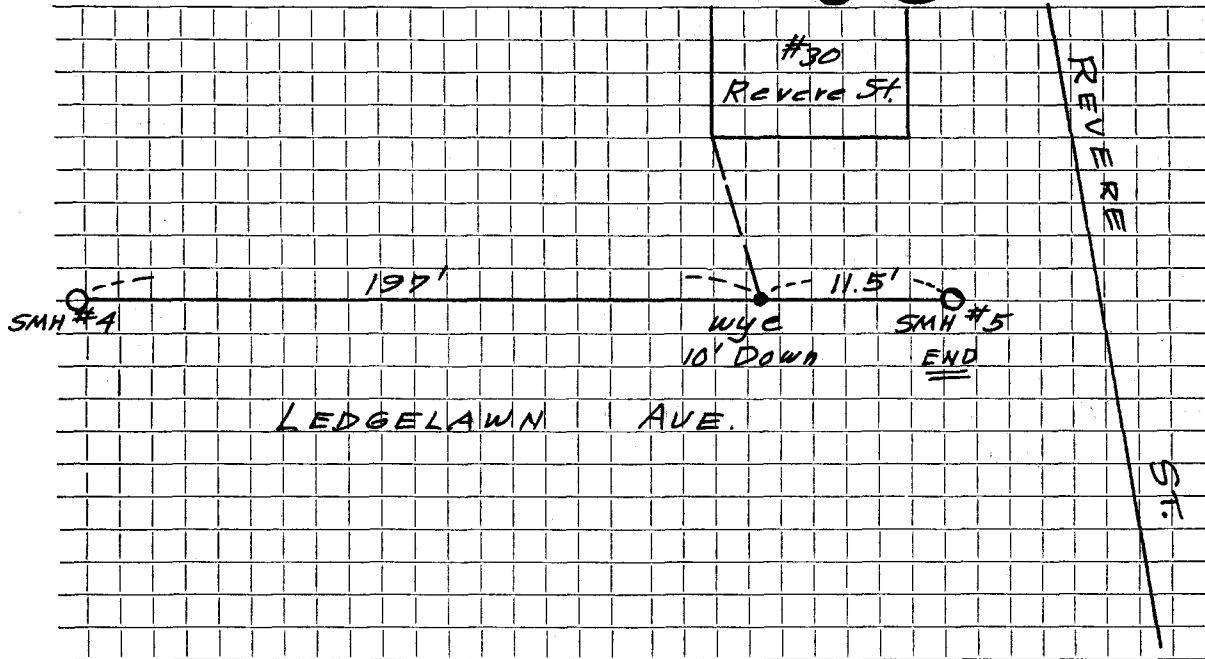

Connection made in Street. Work completed

Remarks:

.....

.....