

Name F. L. Jones

Service No. 32

Address 34 Revere Street

34 Revere Street

Location

Kind of Pipe

Size 6"

Size of Main 8"

~~Repair Renewal~~ — New Service

W 0# 28.55

Location Camm 8-26-63

Date	Material	Amount	Total	Date	Amount
5/20/63	Labor	85 68		4-22-63	200 00
	10% O.H.	8 57	94 25	9-16-63	3 60
	52 6" Transite Pipe @ .88		45 76		203 60
	1 6" 90° Transite Elbow		4 09		
	1 Yard Loam		3 00		
	18 X 3 Patch		18 00		
	5 Hrs. Town Shovel @ 6.50		32 50		
	2 Hrs. Trucking @ 3.00		6 00		
			203 60		

Bill sent 3.60


DATE _____

TOWN OF LEXINGTON — BOARD OF PUBLIC WORKS

SEWER DIVISION

Sketch of Service Here

34

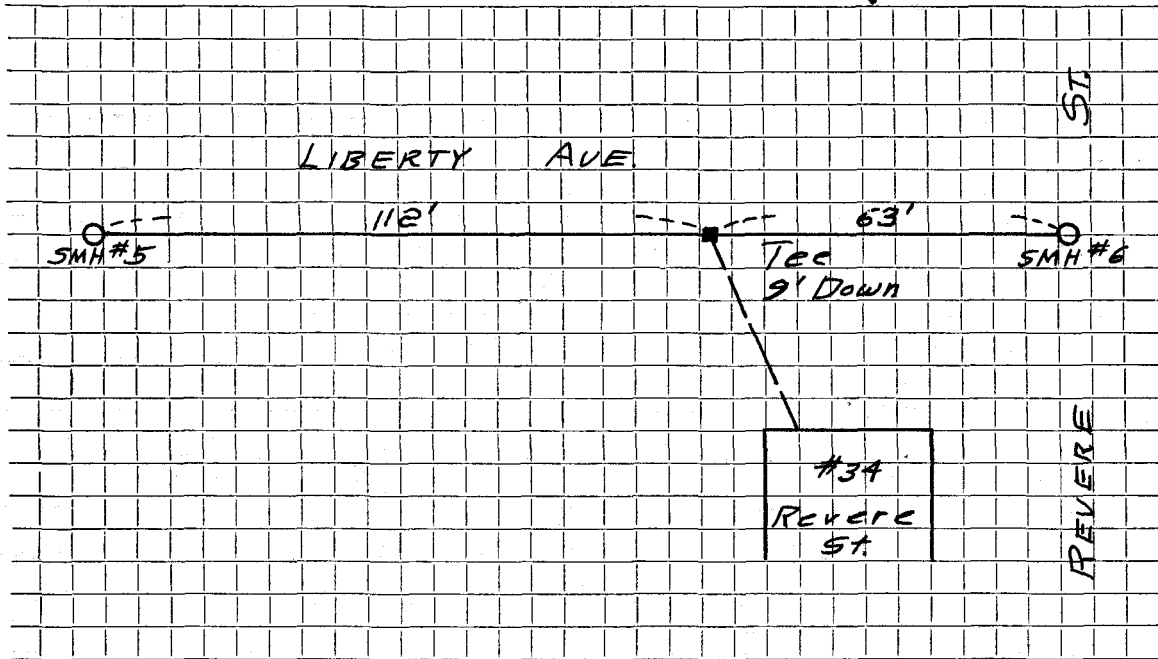

Connection made in Street. Work completed

Remarks:

.....

.....