

Name Alfred Cavaretta

Service No. 148

Address 38 Revere Street

38 Revere Street

Location

Kind of Pipe

Size 6"

Size of Main 8"

~~Repair/ Renewal~~ — New Service

Location Comm 12-18-61

Date	Material	Amount	Total	Date	Amount
10/27/61	Labor	84 93		10-18-61	275 00
10/28/61	"	15 92		12-18-61	45 92
		100 85			229 08
	10% O.H.	10 09	110 94		
	55' 6" Transite Pipe @ .78		42 90		
	1 6" 90° Transite Elbow		5 40		
	1 8 X 6 Service Saddle		5 65		
	1 22½° Transite Bend		6 21		
	2 11¼° Transite Elbow @ 2.24		4 48		
	3 Hrs. Town Shovel @ 6.50		19 50		
	4 Hrs. Trucking @ 3.00		12 00		
	1 Hr. Loader @ 3.00		3 00		
	1 Hr. Trailer @ 3.00		3 00		
	16 X 3 Patch		16 00		
			229 08		


DATE _____

TOWN OF LEXINGTON — BOARD OF PUBLIC WORKS

SEWER DIVISION

Sketch of Service Here

38

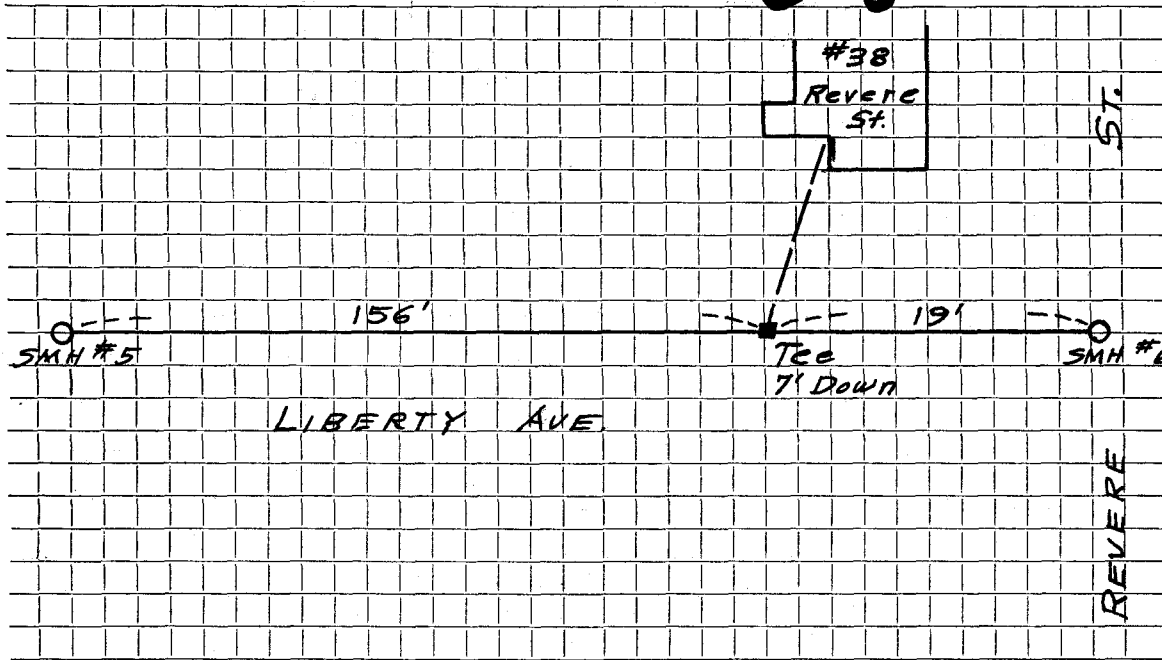

Connection made in Street. Work completed

Remarks: From Liberty Ave