

Name Garrett Wolpert

Service No. 168

Address # 4 Revere St.

4 Revere Street

Location

Kind of Pipe

Size 6"

Size of Main 8"

~~Repair~~ ~~Renewal~~ ~~New Service~~ Valeri Const. Co. Permit #168

Location FEB 15 1965

Date	Material	Amount	Total	Date	Amount
1964 ^(act.)	20' 6" Transite pipe @7.00		140.00	<u>10-6-64</u>	<u>Deposit</u>
	33' 6" Transite pipe				


DATE _____

TOWN OF LEXINGTON — BOARD OF PUBLIC WORKS

SEWER DIVISION

Sketch of Service Here

4

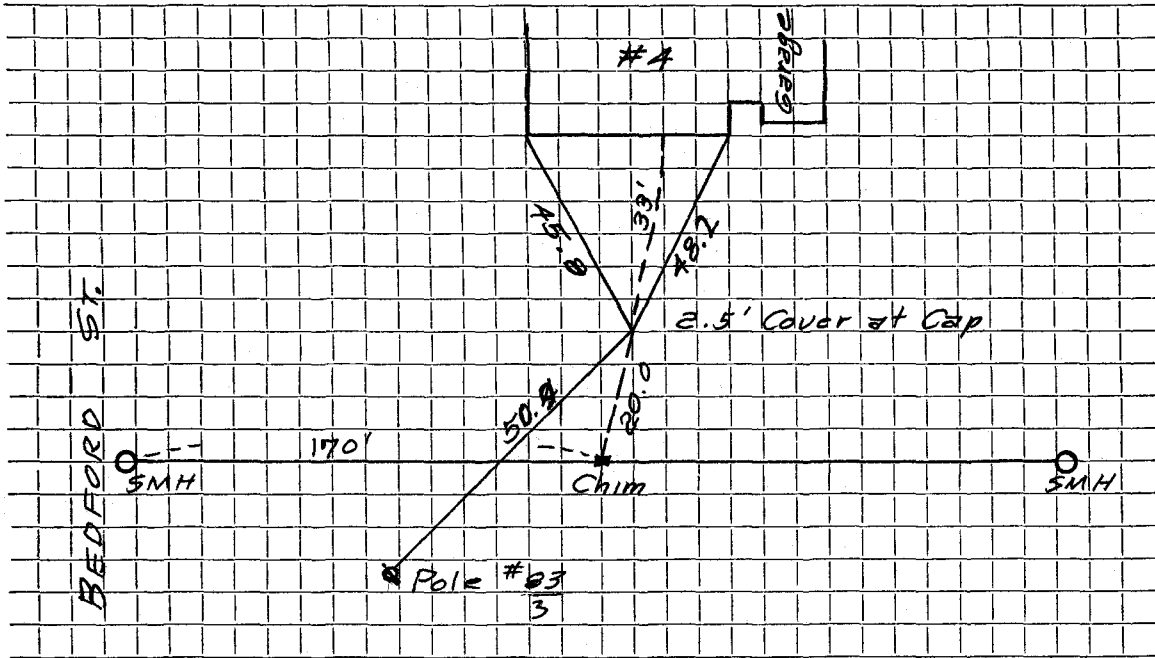

Connection made in Street. Work completed

Remarks:
.....
.....