


TOWN OF LEXINGTON — BOARD OF PUBLIC WORKS
SEWER DIVISION

DATE 5-70 CE/CR
3' Below Cellar
2' P

Sketch of Service Here **7A**

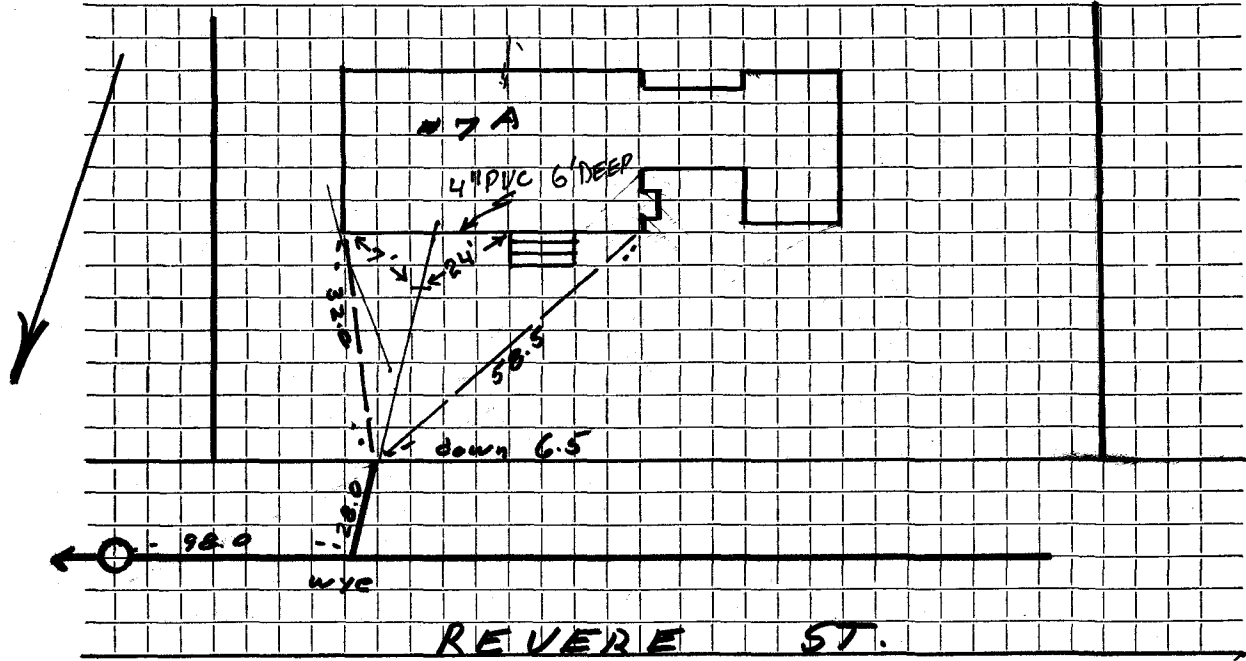

Connection made in Street. Work completed

Remarks:
.....
.....