

Name James W. Wilson

Service No. 135

Address ~~28~~ REVERE ST.

8 Revere Street

Location

FEB 12 1973

Kind of Pipe

Size

6" A.C.

Size of Main

8" A.C.

Repair—Renewal—New Service

Trebino #2162

Location


Date	Material	Amount	Total	Date	Amount
9/29/72	24.0 A.C. @ 9.00	216.00		9/19/72	Deposit 216.00
9/25/72	40' 6" Transite				
	10' 4" Cast Iron				

DATE _____

TOWN OF LEXINGTON — BOARD OF PUBLIC WORKS
SEWER DIVISION

Sketch of Service Here

8

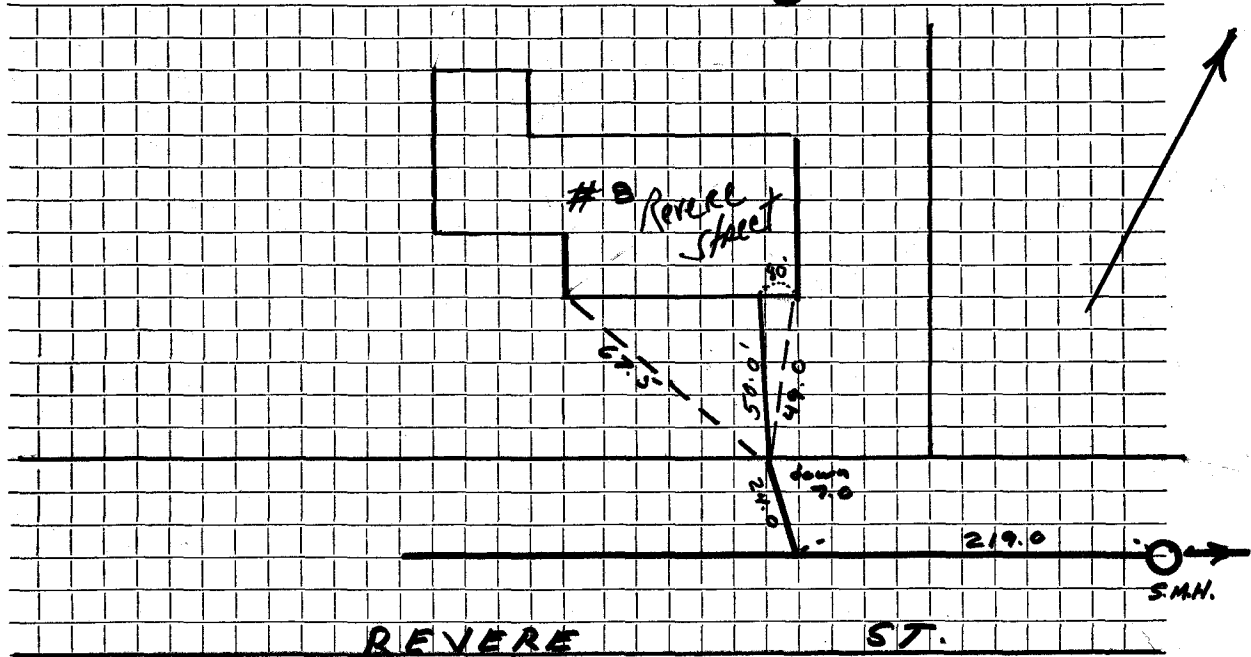

Connection made in Street. Work completed

Remarks:

.....

.....