

Name J. Gellini

Service No. 215

Address 10 Revolutionary Road

10 Revolutionary Road

Location

Kind of Pipe

Size 6"

Size of Main 10"

~~Repair~~ ~~Renewal~~ New Service

Location Com 12-31-59

Date	Material	Amount	Total	Date	Amount
10-28-59	Labor 19.12			10-23-59	200.00
10-29-59	Labor 63.06	82.18		12-31-59	41.56
	10% O.H.	8.22	90.40		158.44
	50' 6" Transite pipe @.70		35.00		
	1 6" 90° Transit Elbow		5.29		
	3 hrs. Town Shovel @6.50		19.50		
	3 hrs. Trucking @.75		2.25		
	1 hr. Rogers Trailer @3.00		3.00		
	1 hr. Trucking @3.00		3.00		
			158.44		
	Labor				

TOWN OF LEXINGTON—DEPT. OF PUBLIC WORKS

SEWER DIVISION

DATE.....

NO.....


The undersigned applies for the construction of a particular sewer connecting No.....
Street and hereby agrees to comply with the Rules and Regulations governing the construction and use of Particular
Sewers, as now or at any future time established by the Board of Selectmen.

Am't of estimate \$.....

Am't Paid \$.....

..... Owner

Sketch of Service Here

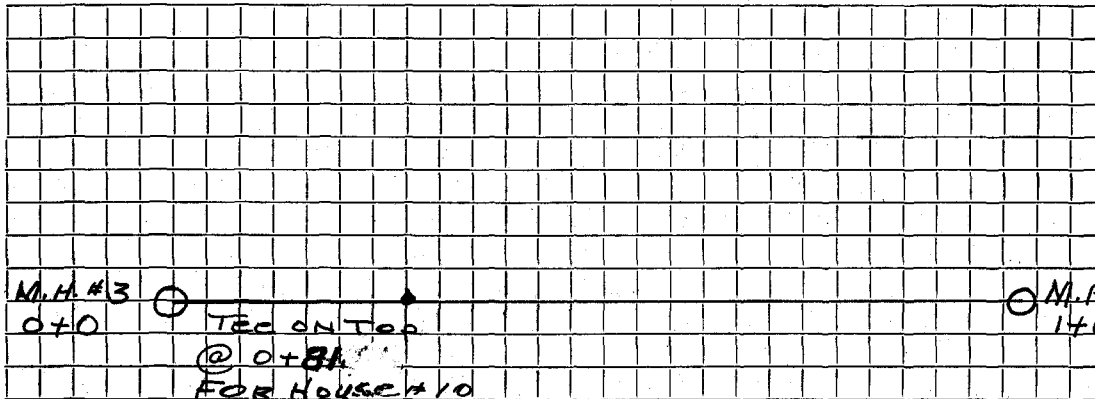

Connection made in..... Street.

Work completed.....19..

Remarks: