

Name John Desmond

Service No. 57

Address 5 Revelutionary Road

5 Revolutionary Road

Location

Kind of Pipe

Size 6"

Size of Main 8"

~~REPAIR WORK~~ - New Service

Location *Comm 7-6-59*

Date		Material	Amount		Total		Date		Amount	
5-22-59		Labor	84	93			<i>5-8-59</i>	<i>Deposit</i>	150	00
		10% O.H.	8	49	93	42	<i>7/3/59</i>	<i>Paid</i>	16	76
	48	6" Transite pipe @70			33	60			166	76
	10	Ton 1 1/4" Stone @1.50			15	00				
	1	1 1/4" Transite Elbow			2	24				
	3	Hours Town Shovel @6.50			19	50				
	4	Hours Trucking @75			3	00				
					<u>166</u>	<u>76</u>				
		<b>Labor</b>								
							<i>Bill</i>	<i>500 7-6-59</i>	<i>16.76</i>	

# TOWN OF LEXINGTON—DEPT. OF PUBLIC WORKS

## SEWER DIVISION

DATE.....

NO.....


The undersigned applies for the construction of a particular sewer connecting No.....  
 Street and hereby agrees to comply with the Rules and Regulations governing the construction and use of Particular  
 Sewers, as now or at any future time established by the Board of Selectmen.

Am't of estimate \$.....

Am't Paid \$.....

..... Owner

### Sketch of Service Here

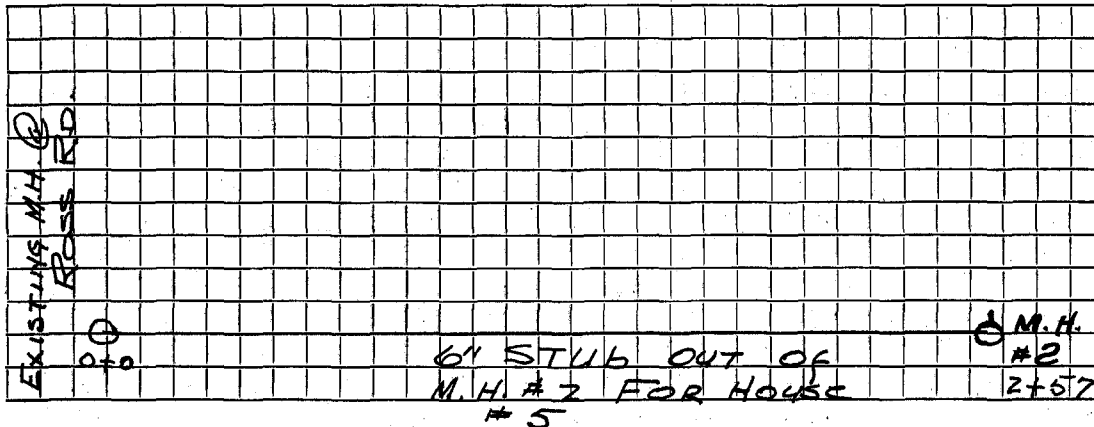

Connection made in..... Street.

Work completed..... 19..

Remarks: