

Name

Service No.

Address 22 RICHARD

McLAUGHLIN

Location

Kind of Pipe

Size

Size of Main

Repair ~~Renewal~~ New Service

Location

Date

Material

Amount

Total

Date

Amount

11/2017

6" SDR

6" CLEANOUT

.6" CAP

.6" SDR RISER


.6" BTCC WYE

6" x 6' FERNCO

DATE 11/2017

TOWN OF LEXINGTON — BOARD OF PUBLIC WORKS
SEWER DIVISION

Sketch of Service Here

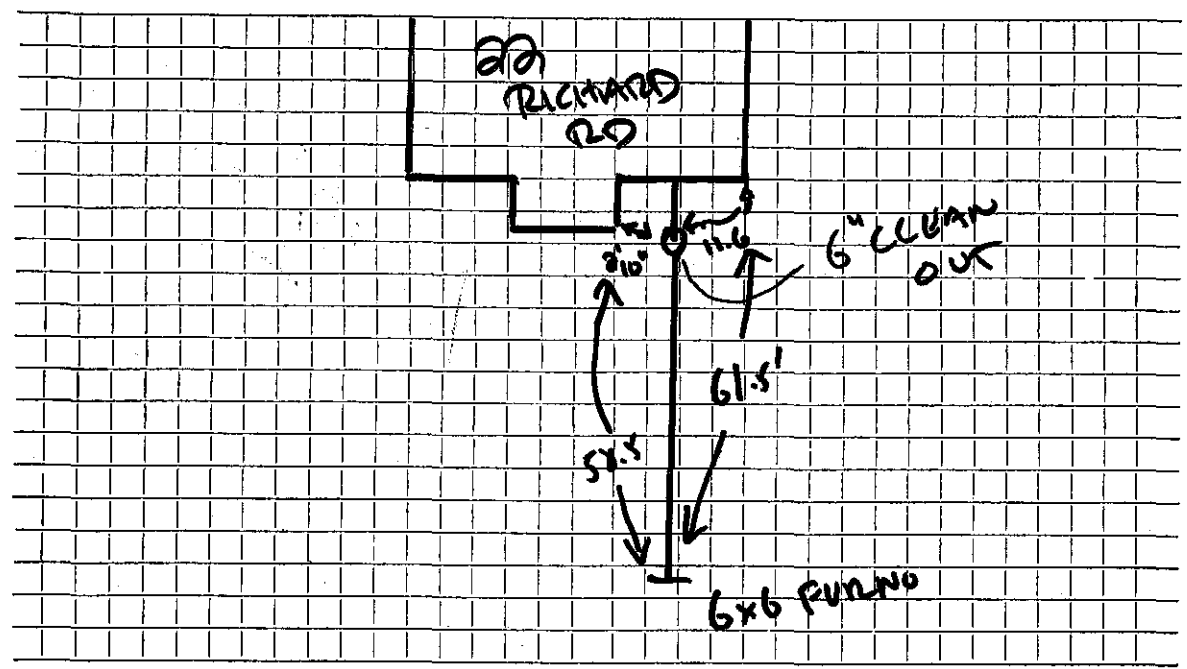

Connection made in RICHARD Street. Work completed M. LAUGHLIN

Remarks: