

Name

Service No.

Address

10 Richard Rd

Location

Kind of Pipe

Size

Size of Main

Repair—Renewal—New Service

Location

Date

Material

Amount

Total

Date

Amount

Nov. 5, 1999

SERVICE RENEWED to
PROPERTY LINE

20.6 - 6" PVC

1- 6" x 6" PVC to Clay
FRANCO

Name Roy Homes, Inc.

Service No. 1-1942 846

Address ~~Central Square, Cambridge, Mass.~~

10 Richard Rd.

Location

10 Richard Rd.,

Kind of Pipe

Size

6"

Size of Main

8"

~~Repair~~ ~~Renewal~~ New Service

Location

Date	Material	Amount	Total	Date	Amount
2/6/42	65½ hrs. @ 60¢	39 30			
Jan 7/6/42	3 " @ 65¢	1 95		Jan. 6 42	75.00
	4 " @ 75¢	3 00	44 25	April 16, 1942	5.25
	10% Overhead		4 43		86.85
	46' 6" Sewer Pipe @ 16¢		7 36		
	Jointing compound		2 76		
	Gravel		50		
	2 hrs. compressor @ 2.25		4 50		
	3 hrs. trucking @ 75¢		2 25		
			66 05		
AUG 1977	TEARDOWN: COMPLETED SEWER W/ FERNCO AT NEW FOUNDATION Labor DID NOT RENEW CLAY PIPE NOT APPROVED by D.P.W.				

Hadley Press, Inc., Lexington

TOWN OF LEXINGTON—BOARD OF PUBLIC WORKS

SEWER DIVISION

DATE Dec 29, 1941

Lab. ref.

NO. _____

The undersigned applies for the construction of a particular sewer connecting No. 10 Richard Road, Street and hereby agrees to comply with the Rules and Regulations governing the construction and use of Particular Sewers, as now or at any future time established by the Board of Selectmen.

Am't. of Estimate \$ 75-

Am't. Paid \$ _____

Builder

Geo. I.

67 Atholston Rd.

Raymond J. ...


Pepper

Owner

Newton

Sketch of Service Here

10

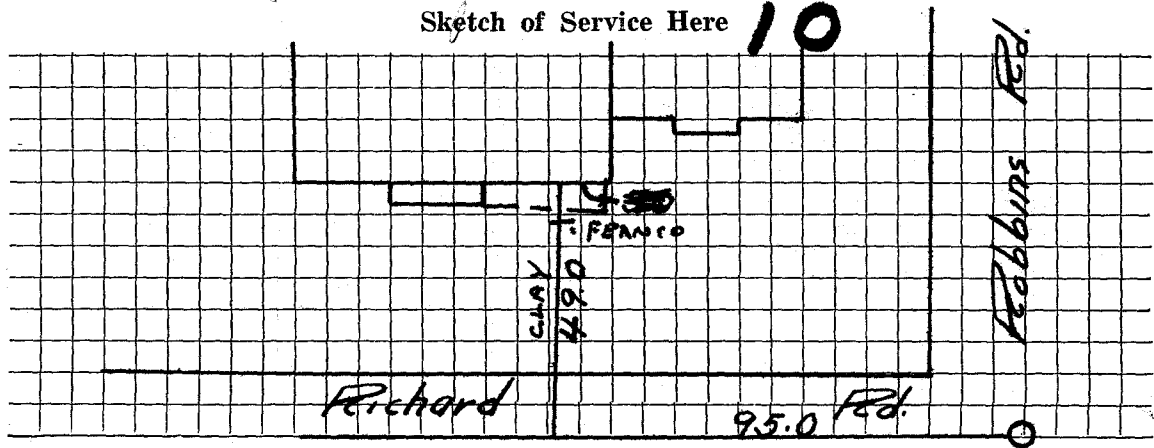

Connection made in _____ Street.

Work completed _____ 19


Remarks: NOT INSP OR APPROVED

DATE _____

TOWN OF LEXINGTON — BOARD OF PUBLIC WORKS

SEWER DIVISION

Sketch of Service Here

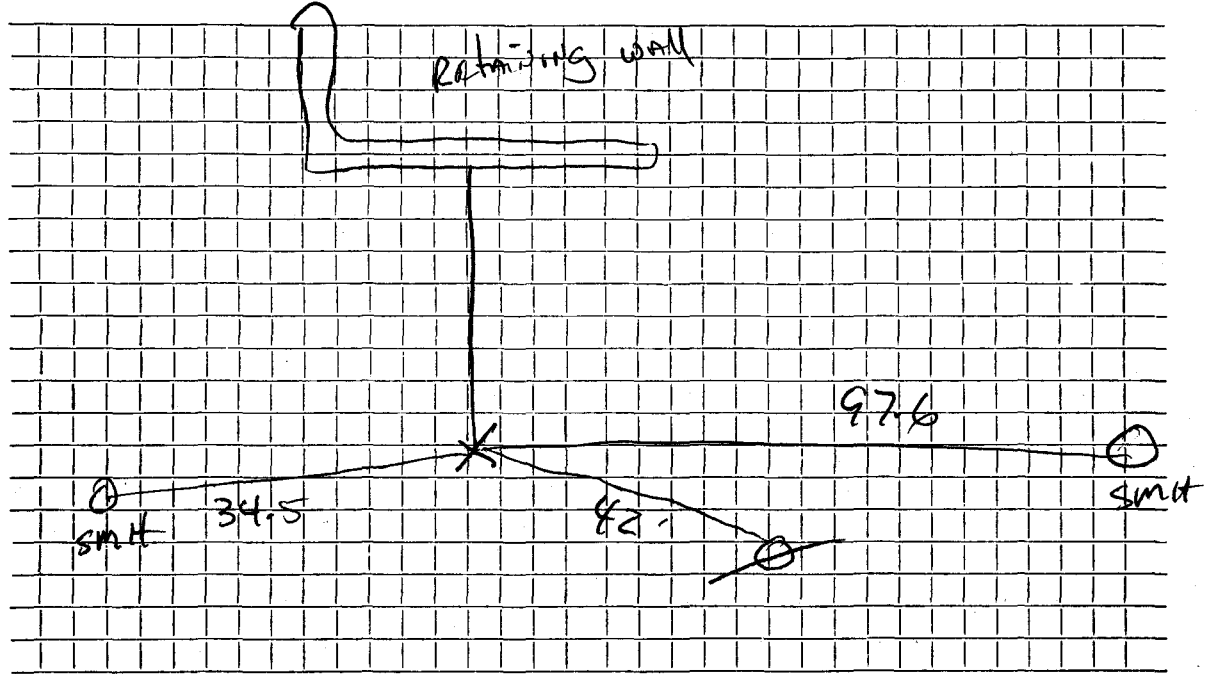

Connection made in Street. Work completed

Remarks: SERVICE COMES OUT ON RICHARD RD

.....
.....