

Name C Sykora

Service No. 165

Address 15 Richard Road ST

15 Richard Road

Location

Kind of Pipe

Size 6"

Size of Main 8"

~~Repair~~ ~~Renewal~~ New Service

Location Corner - 12-15-58

Date	Material	Amount	Total	Date	Amount
10/8/58	labor	39 97		10-1-58	75 00
	10% overhead	4 00		1-19-59	53 32
			43 97		128 32
	70' 6" transite sewer pipe @ .70	49 00			
	1 1 1/4" bend 6" Transite	5 10			
	3 1/2 hrs. town shovel @ 6.50	22 75			
	2 hrs. trucking @ .75	1 50			
	1 hr trucking @ 3.00	3 00			
	1 hr Rodger trailer @ 3.00	3 00			
			128 32		
	Labor				
				Bill sent 1-5-58	53.32

TOWN OF LEXINGTON—DEPT. OF PUBLIC WORKS
SEWER DIVISION

DATE.....

NO.

The undersigned applies for the construction of a particular sewer connecting No.....
Street and hereby agrees to comply with the Rules and Regulations governing the construction and use of Particular
Sewers, as now or at any future time established by the Board of Selectmen.


Am't of estimate \$.....

Am't Paid \$.....

..... Owner

15 Sketch of Service Here

SAME TRENCH AS WATER

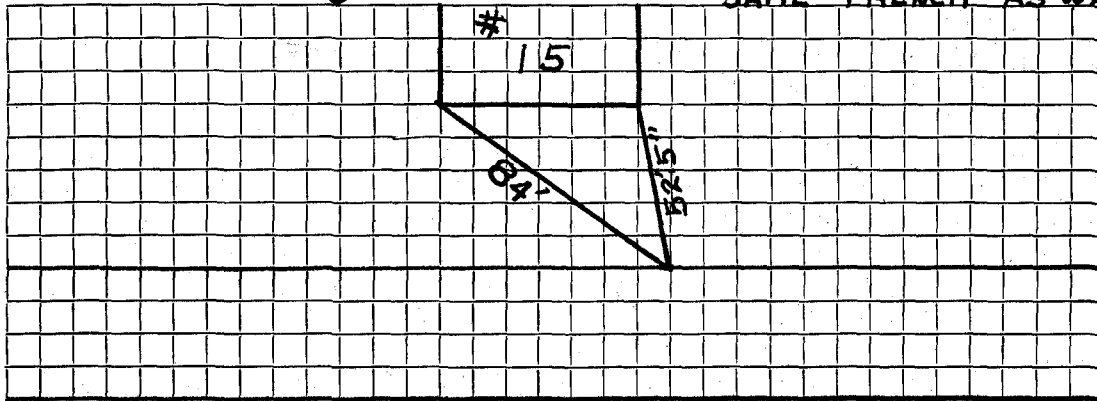

Connection made in..... Street.

Work completed.....19..

Remarks: