


DATE _____

TOWN OF LEXINGTON — BOARD OF PUBLIC WORKS
SEWER DIVISION

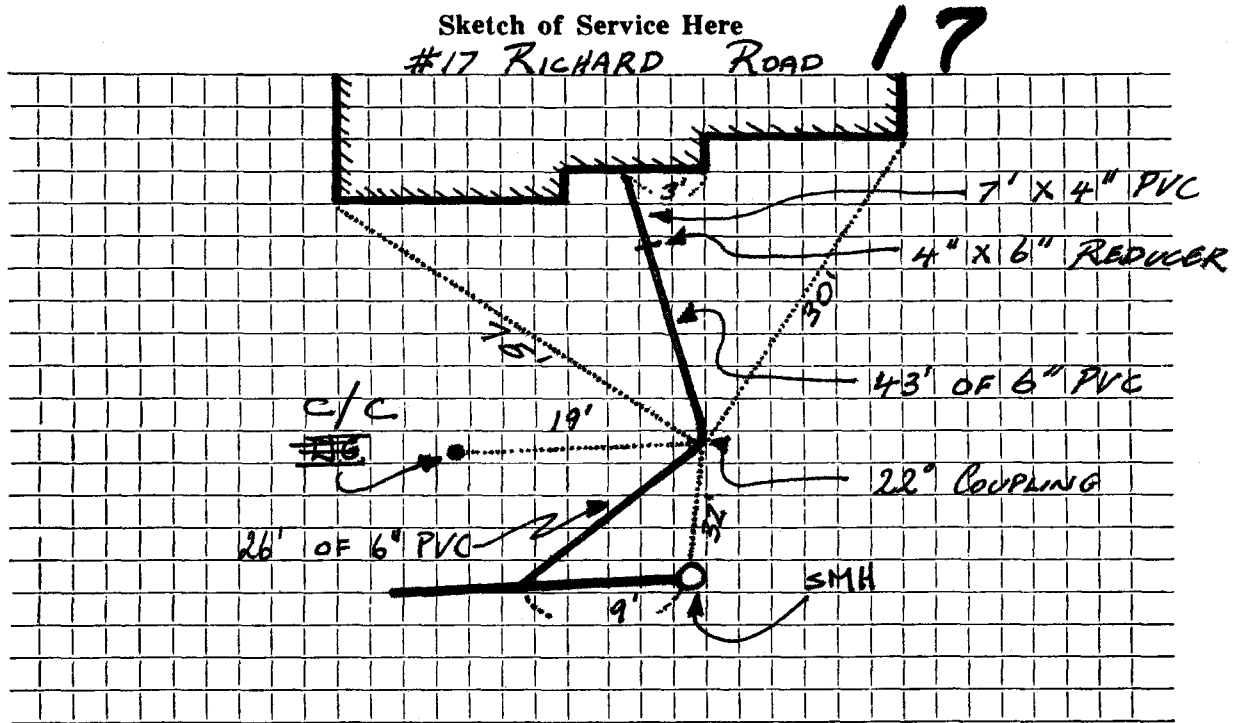

Connection made in RICHARD ROAD ~~Street~~ Work completed

Remarks:
.....
.....