

Name Edwin H. Nelson

Service No. 32 848

Address 34 Marlboro Road, Waltham, Mass.

18 Richard Rd.

Location

18 Richard Road

Kind of Pipe

Size 6"

Size of Main 8"

Repair—Renewal—New Service

Location

Date 1941	Material	Amount	Total	Date	Amount
Dec. 23	48 hrs. @ 60¢	28 80		Dec 11 1941	75 00
Jan 17/29/41	16 " @ 65¢	10 40		Jan 8 1942	5 26
	4 " @ 70¢	2 80	42 00	April 30 1942	35
	10% Overhead		4 20		
	50' 6" Sewer pipe @ 16¢		8 00		
	Joint compound		3 00		
	Compressor, 5 hrs. @ 2.25		11 25		
	Trucking, 2 hrs. @ 75		1 50		
	Trench repairs		10 66		
			80 61		
				Refund from Water service #151 to be credited to this account.	
				Bill 35¢ sent 4/22/42	
					35
					56
					520
					34
	Labor				

Hadley Press, Inc., Lexington

McNelson says any repairs should be made by him.

TOWN OF LEXINGTON—BOARD OF PUBLIC WORKS
SEWER DIVISION

DATE Dec 6 1941

The undersigned applies for the construction of a particular sewer connecting No. 18 Richard Rd Street and hereby agrees to comply with the Rules and Regulations governing the construction and use of Particular Sewers, as now or at any future time established by the Board of Selectmen.


Am't. of Estimate \$ 75⁰⁰

Am't. Paid \$ _____

Edwin H. Nelson Builder
Owner
34 Marbaro Rd Haltham

owner digs.

Sketch of Service Here

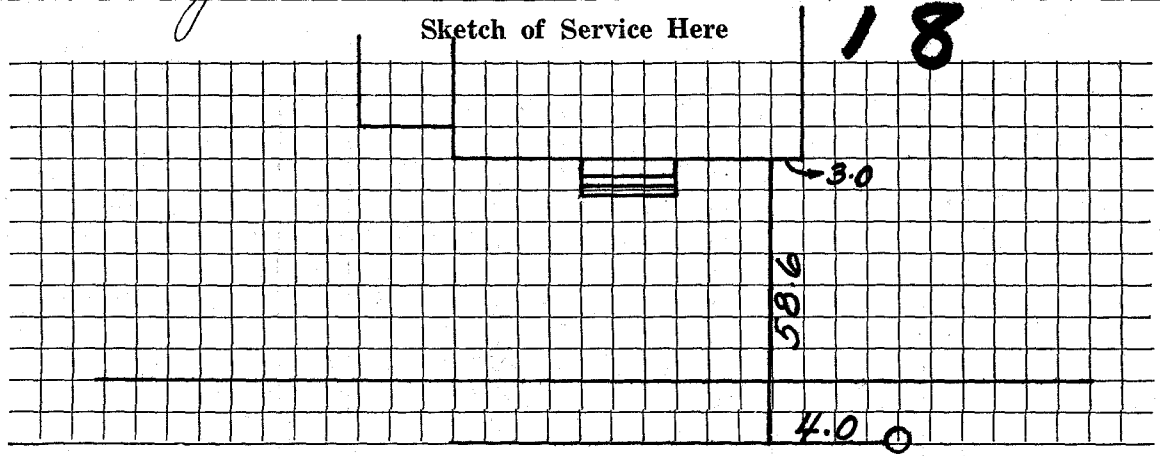

Connection made in _____ Street.

Work completed _____ 19

Remarks: