

Check from Builder:

Name Merle Miller (Owner: Merton Jillson)

Service No. 17 849

Address 104 Mt. Vernon Street, Malden

20 Richard Rd. Location 20 Richard Road

Kind of Pipe Size 6" Size of Main 8"

Repair - Renewal - New Service Location

Date 1940	Material	Amount	Total	Date	Amount
12-5-40	6 hrs. @.55	3 30		November 1940 Deposited	50 00
Jan 12 1940	14 hrs. @.60	8 40	11 70	Dec 31, 1940 Refund	18 10
	10% Overhead		1 17		31 90
	54' 6" Sewer Pipe	@.16	8 64		
	1 6" 1/8 Bend		65		
	Joint Compound		3 24		
	Trucking, 2 hrs.	@.75	1 50		
	Patching		5 00		
			\$31 90		
	Labor				

Hadley Press, Inc., Lexington

TOWN OF LEXINGTON—BOARD OF PUBLIC WORKS

SEWER DIVISION

DATE Nov. 5, 1940

NO. 20 Richard Rd

The undersigned applies for the construction of a particular sewer connecting No. 20 Richard Rd Street and hereby agrees to comply with the Rules and Regulations governing the construction and use of Particular Sewers, as now or at any future time established by the Board of Selectmen.


Am't. of Estimate \$ 20.00

Am't. Paid \$ _____

Morton Johnson
By Marle Miller Owner

Sketch of Service Here

20

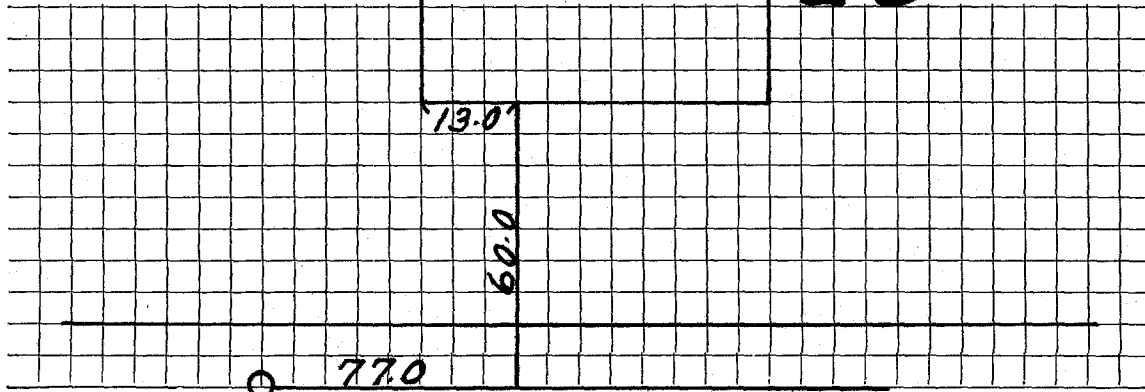

Connection made in _____ Street.

Work completed _____ 19

Remarks: