

Name **Albert Brun**

Service No. <sup>45</sup> **1094**

Address **21 Richard Road**

**Lexington, Mass.**

Location **21 Richard Road**

Kind of Pipe

Size **6"**

Size of Main **8"**

~~Repair~~ **RENEWAL** — New Service

Location

Date	Material	Amount	Total	Date		Amount
Oct. 17, '47	Labor	28 85	28 85	Oct 9 '47	Deposited	100 00
	10% Overhead		2 89	Nov 29 '47	Expended	9 57
	42' - 6" Sewer Pipe @ .26		10 92			90 43
	Joint Compound		2 52			
	Hired Shovel 4½ hrs. @ 7.00		31 50			
	Loader 1 hr. @ 3.00		3 00			
	Trucking 1 hr. @ .75		75			
	Patching 10 x 3		10 00			
			<u>90 43</u>			
	Labor					
	<i>Com 11-24-47</i>					

TOWN OF LEXINGTON—DEPT. OF PUBLIC WORKS

SEWER DIVISION

DATE .....

NO. ....


The undersigned applies for the construction of a particular sewer connecting No. .... Street and hereby agrees to comply with the Rules and Regulations governing the construction and use of Particular Sewers, as now or at any future time established by the Board of Selectmen.

Am't of estimate \$. .... 127 Pulnam Street

Am't Paid \$. .... Boston Man

..... Owner

Sketch of Service Here 21

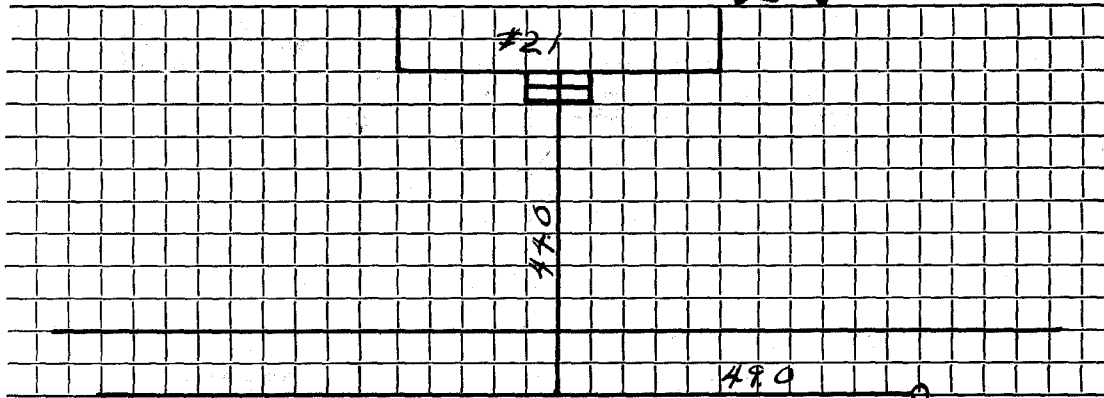

Connection made in ..... Street.

Work completed ..... 19..

Remarks: