


DATE 10-18-01

TOWN OF LEXINGTON — BOARD OF PUBLIC WORKS
SEWER DIVISION

Sketch of Service Here

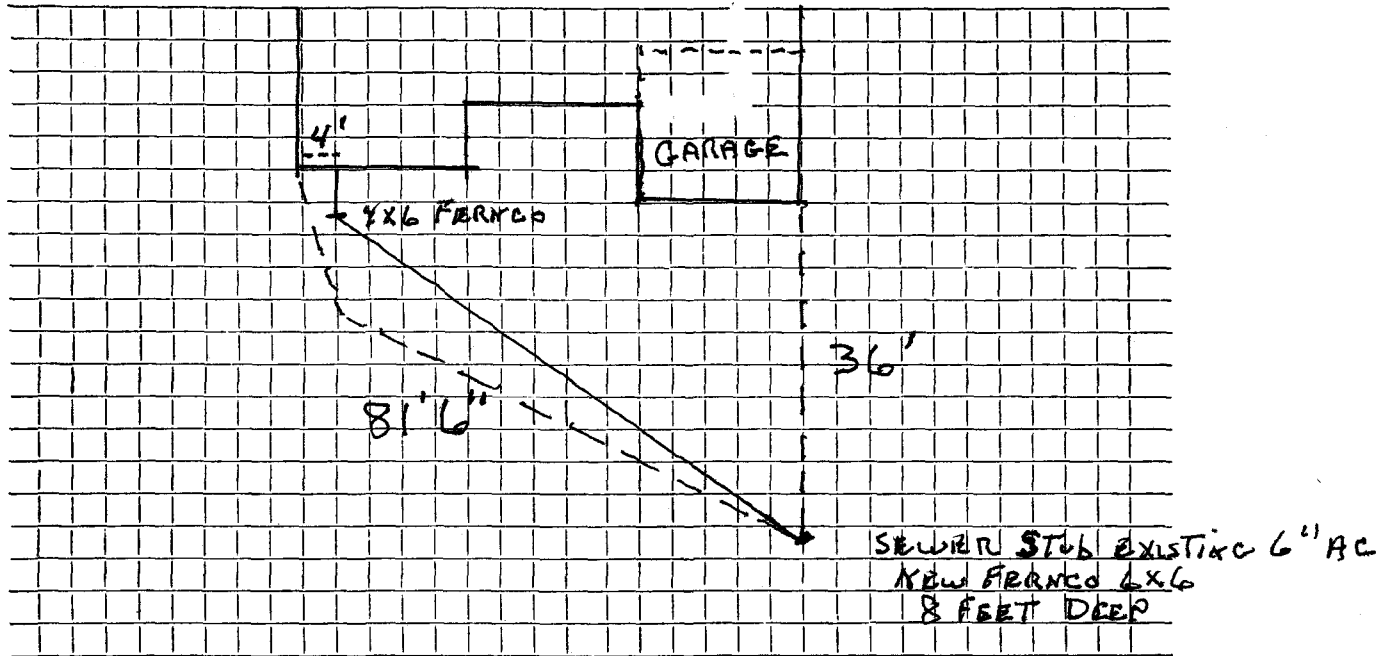

Connection made in Richards Rd Street Work completed

Remarks: INSTALLED BY J. McLAUGHLIN

.....

.....