

Name Robert L. Moody

Service No. 87

Address # 25 Richard Rd.

25 Richard Road

Location

Kind of Pipe

Size 6"

Size of Main 8"

Repair—Renewal—New Service W0# 8067

Location Comm 10-28-63

Date	Material	Amount	Total	Date		Amount
58-5-63	Labor	102 00		3-15-63	Deposit	300 00
		22 09	124 09	10-28-63	Refund	71 94
	10% O.H.		12 41			228 06
	50' 6" Transite Pipe @ .82		41 00			
	1 22 $\frac{1}{2}$ ^o Transite Bend		4 09			
	1 11 $\frac{1}{4}$ ^o " "		4 09			
	1 Clay Elbow		1 88			
	3 hrs. Town Shovel @ 6.50		19 50			
	2 hrs Trucking @ 3.00		6 00			
	15 x 3 Patch		15 00			
			<u>228 06</u>			
	Labor					

TOWN OF LEXINGTON—DEPT. OF PUBLIC WORKS

SEWER DIVISION

DATE

NO.


The undersigned applies for the construction of a particular sewer connecting No. Street and hereby agrees to comply with the Rules and Regulations governing the construction and use of Particular Sewers, as now or at any future time established by the Board of Selectmen.

Am't of estimate \$.

Am't Paid \$.

..... Owner

Sketch of Service Here **25**

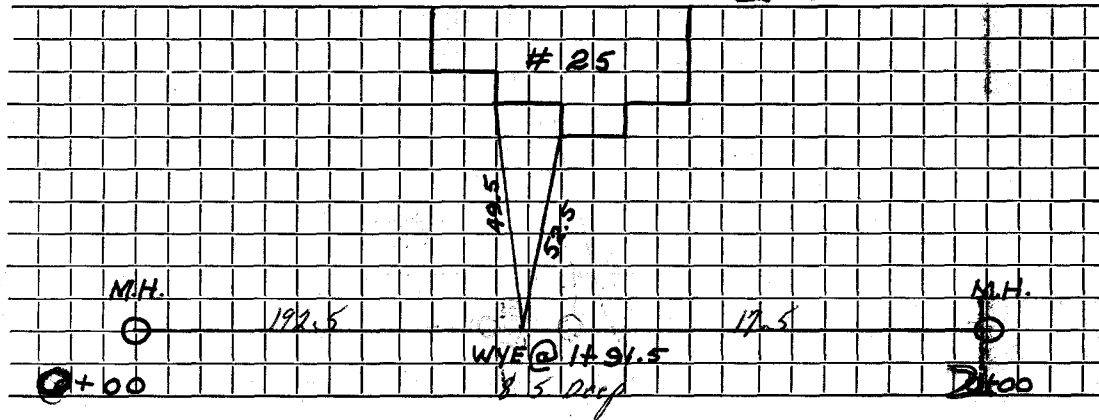

Connection made in Street.

Work completed 19..


Remarks:

DATE _____

TOWN OF LEXINGTON — BOARD OF PUBLIC WORKS

SEWER DIVISION

Sketch of Service Here
Richard RD

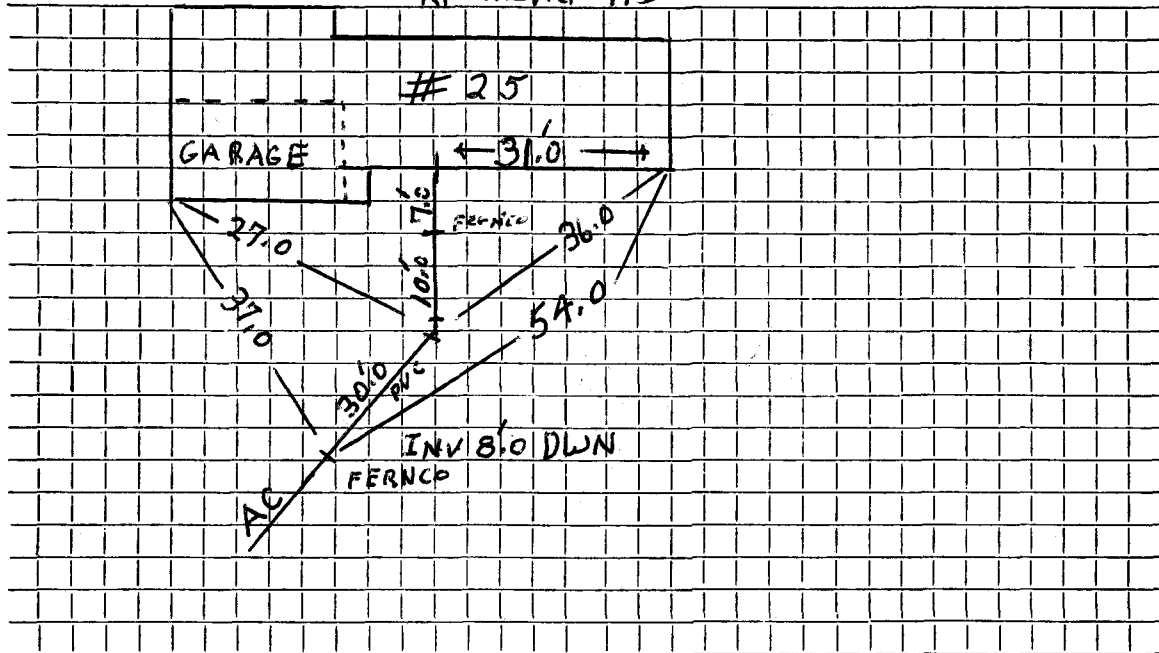

Connection made in Street. Work completed

Remarks:

.....

.....