

Name Philip DeAngelis

Service No. 34

Address # 30 Richards Rd.

30 Richard Road

Location

Comm. 6-10-57

Kind of Pipe

Size 6"

Size of Main 8"

~~Repair - Renewal~~ - New Service

Location

Date	Material	Amount	Total	Date	Amount
4/8/57	Labor	74 48		4-1-57	Deposit 2500 0
	Labor	29 34		6-10-57	Refund 47 69
	10% overhead	10 38	114 20		# 202 31
	55' 6" Transite @.702		38.61		
	3 Hrs. Town Shovel @6.50		19 50		
	4 Hrs. trucking @.75		3 00		
	2 Hrs. Jager Pump @1.00		2 00		
	3 x 10 Patching		10 00		
	2 Hrs. Allis Chalmers @3.00		6 00		
	1 Hr. Rodgers Trailer @3.00		3 00		
	1 Hr. trucking @3.00		3 00		
	labor 1 Hr. Hough @3.00		3 00		
			202 31		

TOWN OF LEXINGTON—DEPT. OF PUBLIC WORKS
SEWER DIVISION

DATE

NO.

The undersigned applies for the construction of a particular sewer connecting No.
Street and hereby agrees to comply with the Rules and Regulations governing the construction and use of Particular
Sewers, as now or at any future time established by the Board of Selectmen.


Am't of estimate \$.

Am't Paid \$.

..... Owner

Sketch of Service Here

30

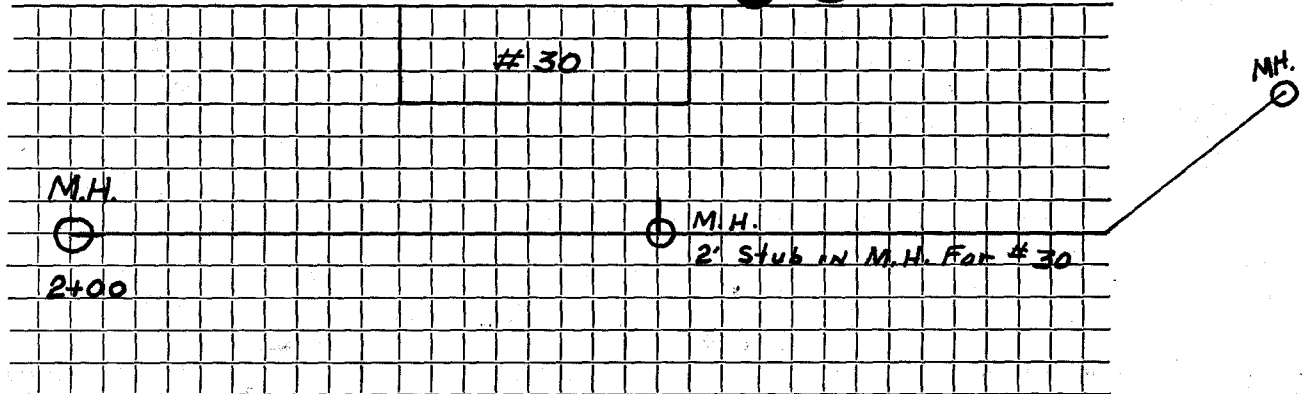

Connection made in Street.

Work completed 19..

Remarks: