

Name Smith, James R.

Service No. 13 843

Address 5 154 Highland Ave., Arlington

5 Richard Road

Location Lot #42 Richards Road

Kind of Pipe

Size 6"

Size of Main 8"

~~Business Break~~ New Service

Location

Date	Material	Amount	Total	Date	Amount
1936					
May 12	15 1/2 hrs. labor @ 60¢	9 30		1-11/38	39 70
Comp. 6-9-36 to Russell 439.76	14 " " @ 55¢	7 70	17 00		
	10% Ovhd. on labor		1 70		
	42' 6" Pipe @ 16¢	6 72			
	Joint. comp.	1 15			
	3 hrs. trucking @ 75	2 25			
	3 " Comp. @ \$3.00	9 00			
	5 St. Dynamite @ 20¢	1 00			
	11 Blasting Caps @ 8¢	88	21 00		
			39 70		
	Labor			Bill mailed 6-9-36	
				Notified 8-20-36 Turn over to L.C. - 9-2-36	

Hadley Press, Inc., Lexington

TOWN OF LEXINGTON—BOARD OF PUBLIC WORKS
SEWER DIVISION

DATE _____


NO. _____

The undersigned applies for the construction of a particular sewer connecting No. _____ Street and hereby agrees to comply with the Rules and Regulations governing the construction and use of Particular Sewers, as now or at any future time established by the Board of Selectmen.

Am't. of Estimate \$ _____

Am't. Paid \$ _____

_____ Owner

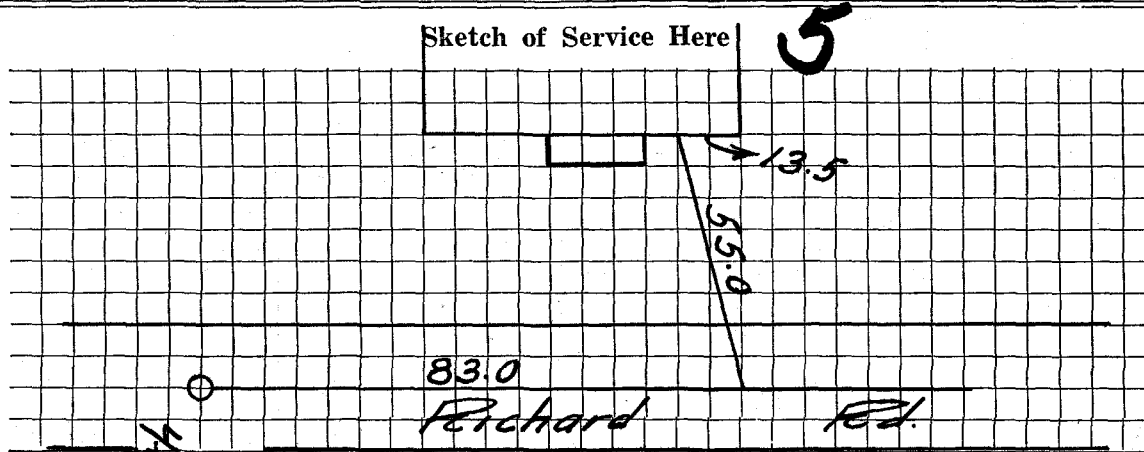

Connection made in _____ Street.

Work completed _____ 19

Remarks:

Plymouth
R.D.