

Name James R. Smith

Service No. 33

244

Address Lot #41, Richards Road (154 Highland Ave., Arl.)

7 Richard Road

Location #7 Richard Rd.

Kind of Pipe

Size 6"

Size of Main 8"

~~Repair-Renewal~~ - New Service

Location

Date	Material	Amount	Total	Date	Amount
10/25/35	8 hrs. labor @ 60¢	4 80		Oct 25 '35	Deposited
mm. # 24.36 2-30-35 to Russell	16 " " @ 55¢	8 80		Jan 23 '36	4c 2 72
	10% Ovhd. on labor		13 60	July 17, 1939	Abated
	40' 6" Sewer Pipe @ 16¢	6 40	1 36		
	Sulphur & Jute	2 00			
	Trucking	1 00			
			9 40		
			<u>\$24 36</u>		
				Letter 4-29-36	
				Bill 6/2/36	
				Letter 8/26/36 - Turn over to J.G.	9/2/36
	Labor				28 164

Hadley Press, Inc., Lexington

TOWN OF LEXINGTON - BOARD OF PUBLIC WORKS

SEWER DIVISION

DATE Oct 23, 1935

NO. _____


The undersigned applies for the construction of a particular sewer connecting No. Lot #41 Richard Rd Street and hereby agrees to comply with the Rules and Regulations governing the construction and use of Particular Sewers, as now or at any future time established by the Board of Selectmen.

Am't. of Estimate \$ 20⁰⁰

Am't. Paid \$ _____

James Smith Owner

40'-

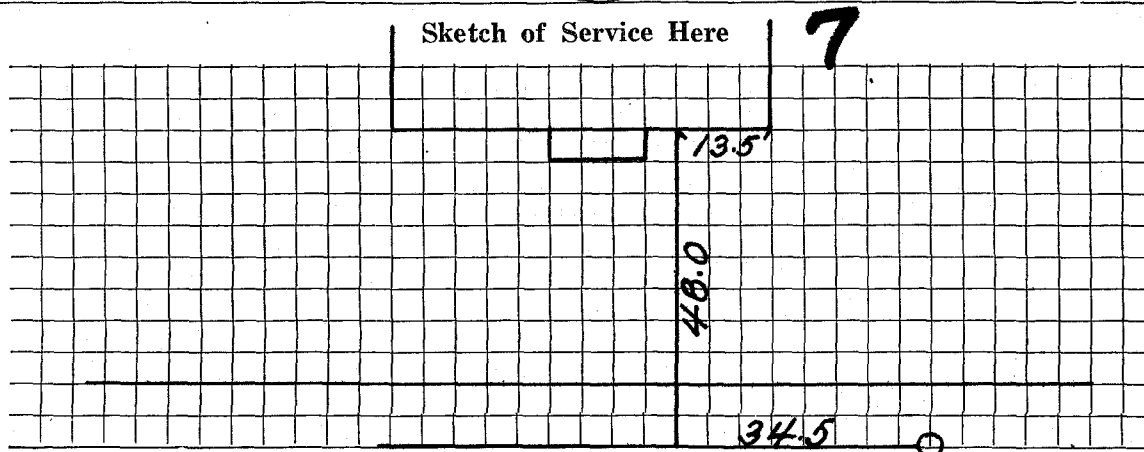

Connection made in _____ Street.

Work completed _____ 19

Remarks: