

Name Norfolk Land Trust

Service No. 10

845

Address ~~449 East Street, Dedham, Mass.~~

9 Richard Rd

9 Richard Road

Location

9 Richard Road

Kind of Pipe

Size 6"

Size of Main 8"

Repair—Renewal—New Service

Location

Date 1939	Material	Amount	Total	Date	Amount
October	30 hrs. @ 55¢	16 50		July 21 1939	50 00
<i>Cover</i>	20 " @ 60¢	<u>12 00</u>	28 50	October 31, 1939	7 67
<i>10/30/39</i>	10% Overhead		2 85	Refunded	42 33
	38' 6" Sewer Pipe @ 15¢		5 70		
	Jointing Compound		2 28		
	4 hrs. Trucking @ 75¢		<u>3 00</u>		
			\$ 42 33		
	Labor				

Hadley Press, Inc., Lexington

TOWN OF LEXINGTON—BOARD OF PUBLIC WORKS

SEWER DIVISION

DATE July 20, 1939

NO. _____


The undersigned applies for the construction of a particular sewer connecting No. 9 Richard Road,
~~Street~~ and hereby agrees to comply with the Rules and Regulations governing the construction and use of Particular
Sewers, as now or at any future time established by the Board of Selectmen.

Am't. of Estimate \$ 50.00

Am't. Paid \$ _____

Norfolk Land Trust Owner

Sketch of Service Here **9**

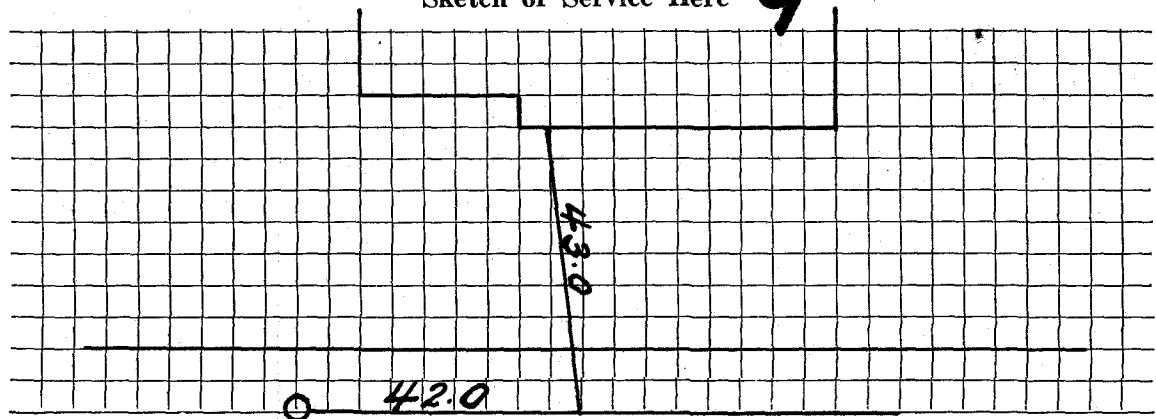

Connection made in _____ Street.

Work completed _____ 19

Remarks: