


DATE _____

TOWN OF LEXINGTON — BOARD OF PUBLIC WORKS
SEWER DIVISION

Sketch of Service Here
53.5

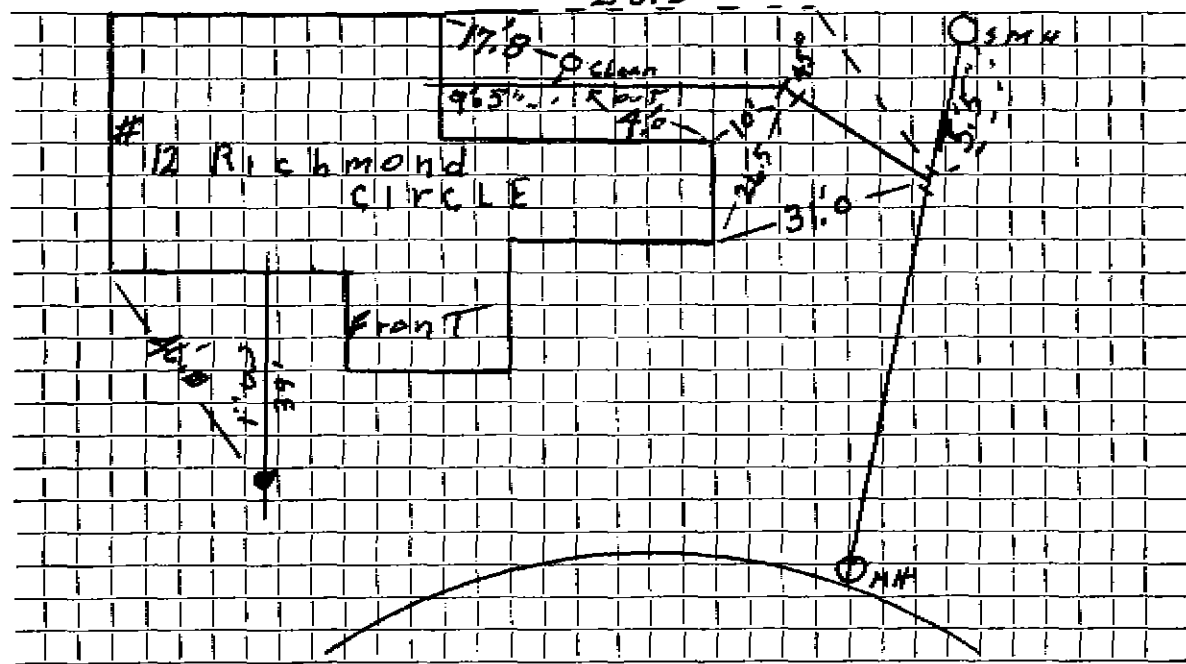

Connection made in Street. Work completed 11/24/09

Remarks:
.....
.....