

Name **GEORGE & ANGELA CARLSON**

Service No.

Address **#45 RIDGE ROAD**

**45 Ridge Road**

Location

Kind of Pipe

Size **6"**

Size of Main **8"**

Repair—Renewal—**New Service**

PERMIT NO. **0694 McLaughlin**

Location

Date

Material

Amount

Total


Date

Amount

**1985 7 6"-PVC**

DATE 7 SEPTEMBER 1995

TOWN OF LEXINGTON — BOARD OF PUBLIC WORKS  
SEWER DIVISION

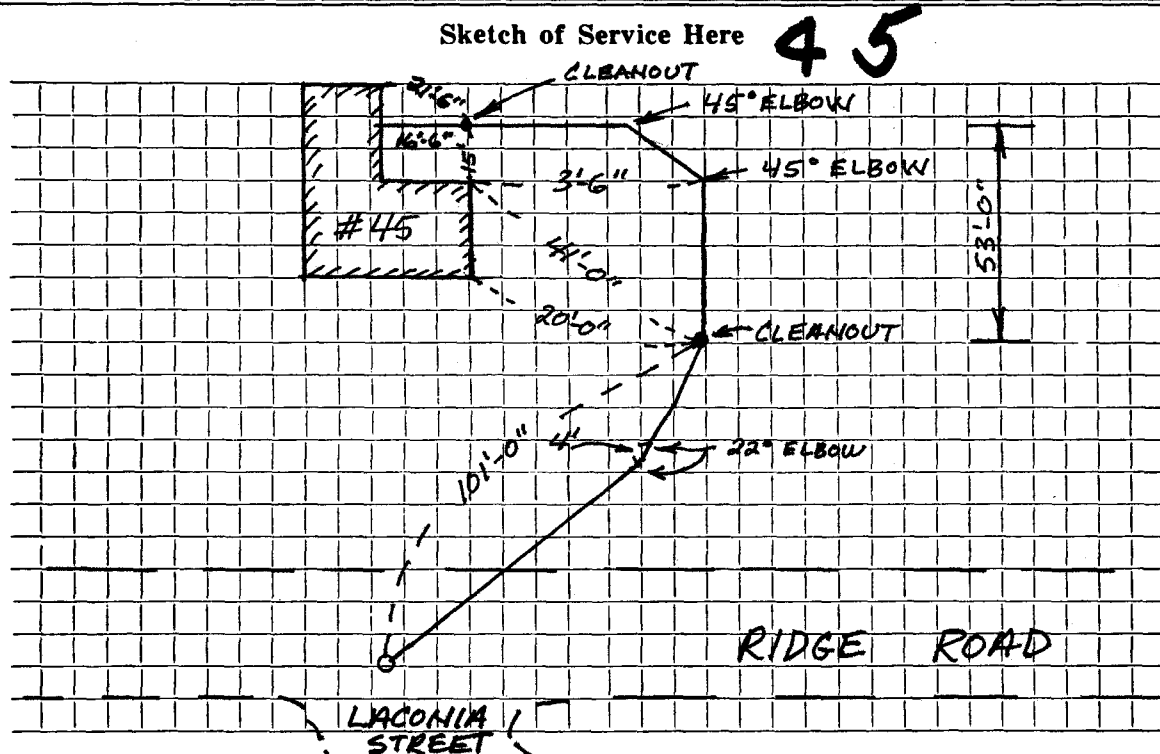

Connection made in RIDGE ROAD Street. Work completed J.M. MCLAUGHLIN

Remarks: .....

RMK GKA

T.W.