

Name GEORGE MOREY

Service No.

Address 95A RIDGE RD (LOT # 41A)

45A Ridge Rd.

Location

Kind of Pipe PVC

Size 6"


Size of Main 8"

Repair—Renewal—New Service

Location

DATE _____

TOWN OF LEXINGTON — BOARD OF PUBLIC WORKS
SEWER DIVISION

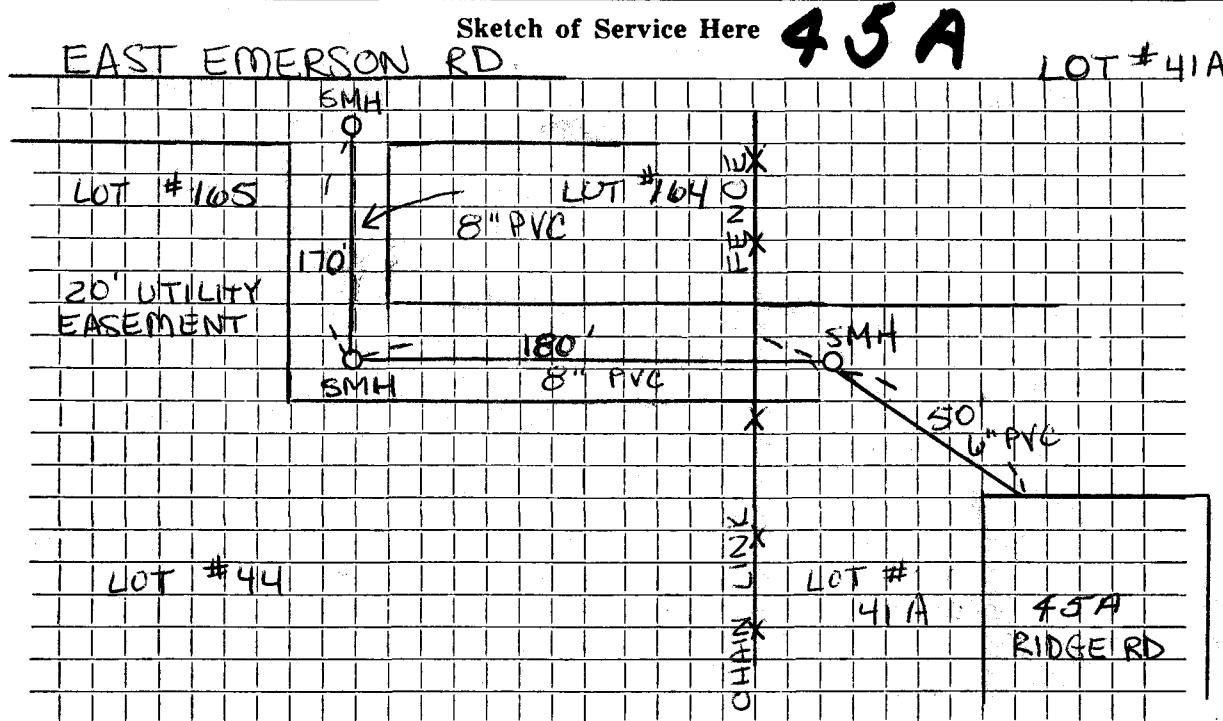

Connection made in EAST...EMERSON...RD... Street. Work completed

Remarks: EASEMENT....OFF....OF....EAST....EMERSON.....