


DATE _____

TOWN OF LEXINGTON — BOARD OF PUBLIC WORKS
SEWER DIVISION

Sketch of Service Here

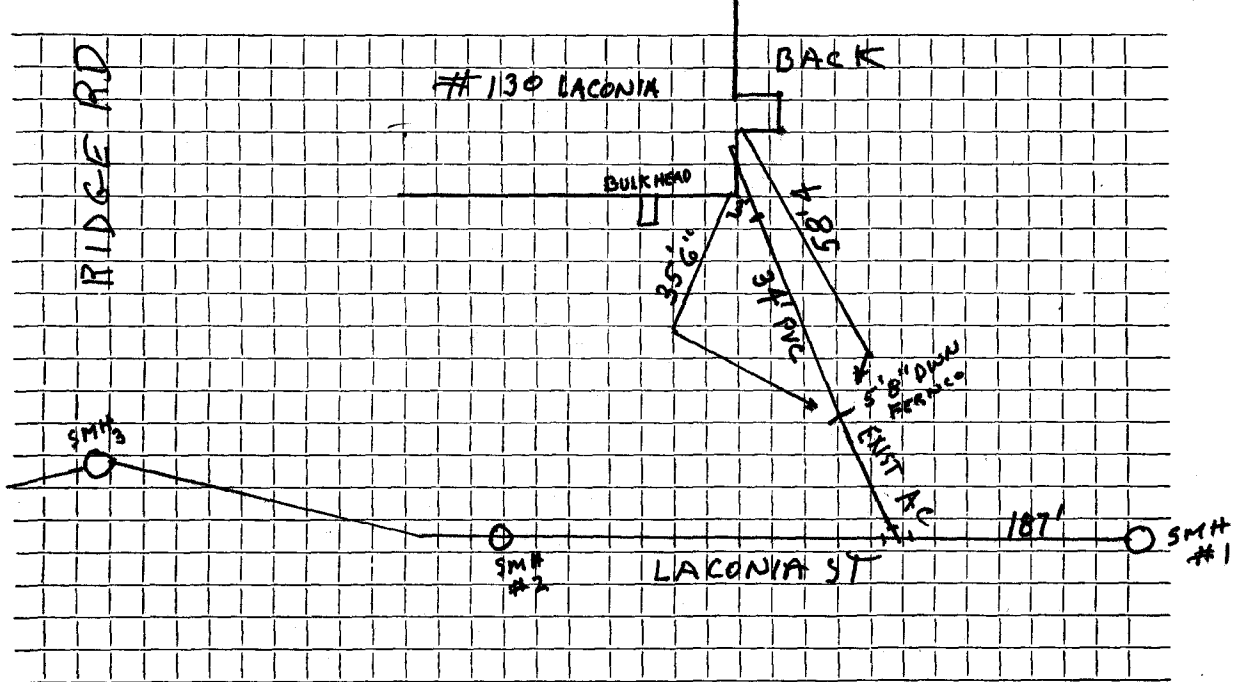

Connection made in LACONIA ST Street. Work completed 4/1/99

Remarks:

.....

.....