

Name

Service No.

Address 15 RINDGE AVE.

(VACANT LOT)

Lots 207-208 Sta 7+75 LF

Location

Kind of Pipe

Size

Size of Main

~~Repair~~ ~~Renewal~~ ~~XXXXXX~~ ~~XXXXXX~~ — New Service


Location

Date	Material	Amount	Total	Date	Amount
8-16-62	Labor	34.84			
	10% O.H.	3.48	38.32		
	20' 6" Transite pipe @.78		15.60		
	2 hrs. Town Shovel @6.50		13.00		
	1 hr. Trucking @3.00		3.00		
	BILL WHEN CONNECTED		69.92		

DATE _____

TOWN OF LEXINGTON — BOARD OF PUBLIC WORKS
SEWER DIVISION

Sketch of Service Here

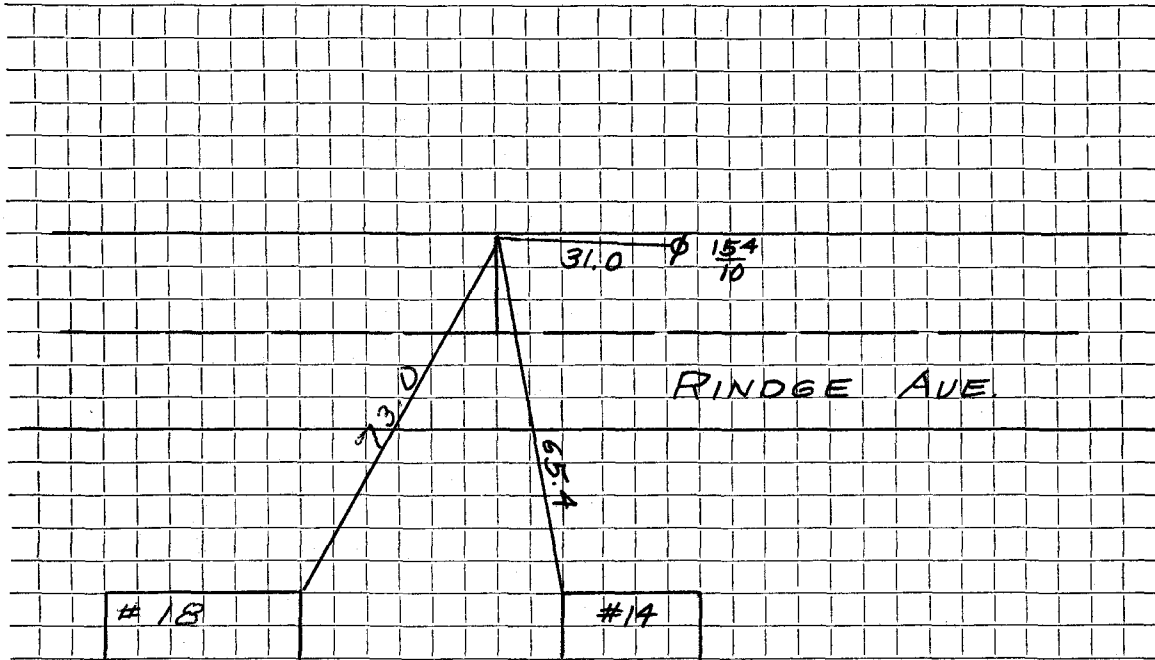

Connection made in Street. Work completed

Remarks:
.....
.....