

Name

Service No.

Address *19 RINDGE AVE.*

*(VACANT LOT.)*

Lot *209-210*

*7+18 Lt.*

Location

Kind of Pipe

Size

Size of Main

Repair—Renewal—New Service

Location


| Date    |  | Material                   | Amount | Total       | Date | Amount |  |
|---------|--|----------------------------|--------|-------------|------|--------|--|
| 8-16-62 |  | Labor                      | 41.25  |             |      |        |  |
|         |  | 10% O.H.                   | 4.13   | 45.38       |      |        |  |
| 20'     |  | 6" Transite pipe @.78      |        | 15.60       |      |        |  |
| 2       |  | hrs. Town Shovel @6.50     |        | 13.00       |      |        |  |
| 1       |  | hr. Trucking @3.00         |        | <u>3.00</u> |      |        |  |
|         |  | <u>BILL WHEN CONNECTED</u> |        | 76.98       |      |        |  |
|         |  |                            |        |             |      |        |  |
|         |  |                            |        |             |      |        |  |
DATE \_\_\_\_\_

TOWN OF LEXINGTON — BOARD OF PUBLIC WORKS

SEWER DIVISION

Sketch of Service Here

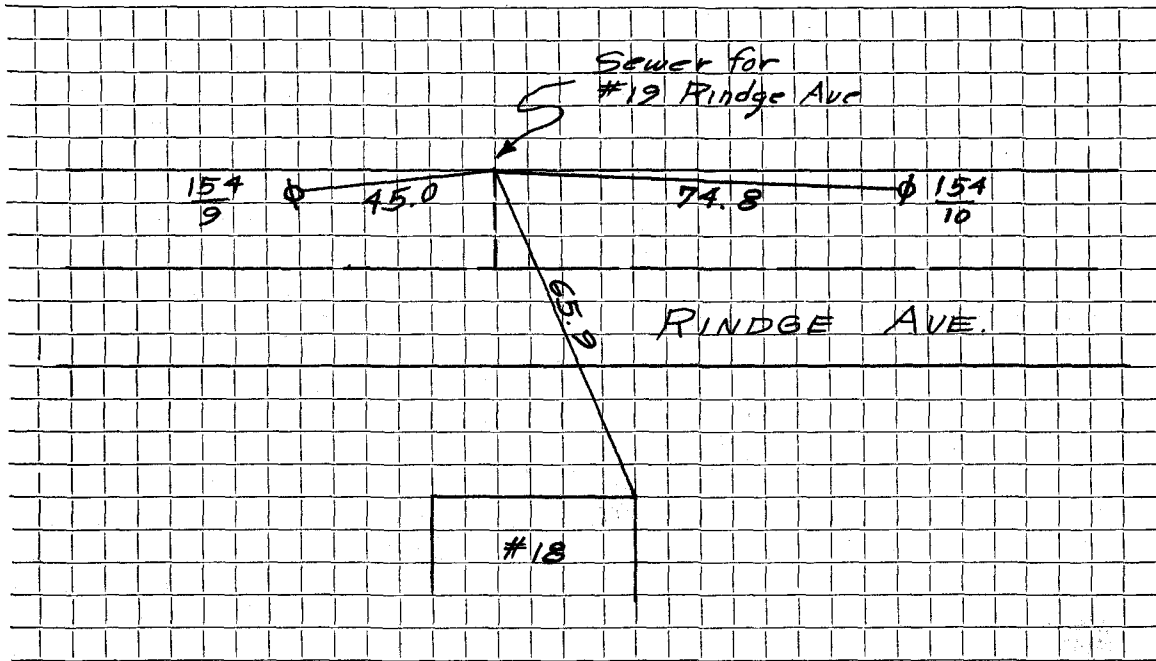

Connection made in ..... Street. Work completed .....

Remarks: .....  
.....  
.....