

Name

Service No.

Address 25 RINDGE AVE.

(VACANT LOT)

Lots 214-215 Part of 213

Sta 5+84 LT

Location

Kind of Pipe

Size

Size of Main

~~Repair/Reconnect~~—New Service


Location

Date	Material	Amount	Total	Date	Amount
8-10-62	Labor	41.79			
	10% O.H.	4.18	45.97		
	16' 6" Transite pipe @.78		12.48		
	3 hrs. Town Shovel @6.50		19.50		
	1 hr. Trucking @3.00		<u>3.00</u>		
	BILL WHEN CONNECTED		80.95		

DATE \_\_\_\_\_

TOWN OF LEXINGTON — BOARD OF PUBLIC WORKS  
**SEWER DIVISION**

Sketch of Service Here

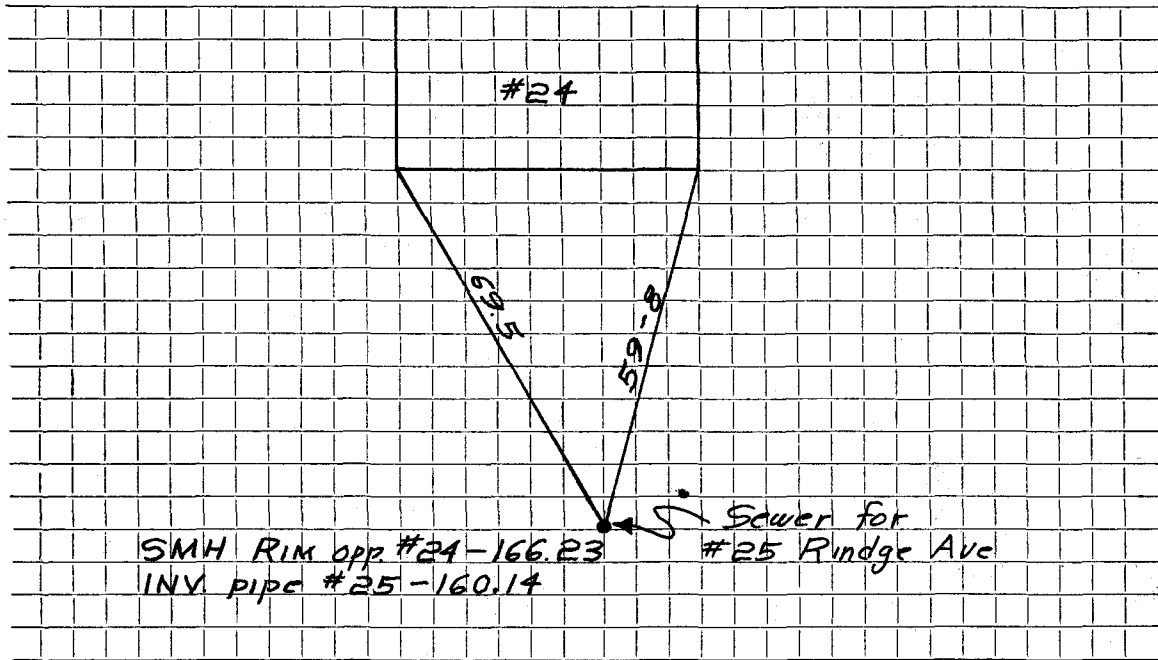

Connection made in ..... Street. Work completed .....

Remarks: .....  
.....  
.....