

Name

Service No.

Address

27 RINDGE AVE. (VACANT LOT)

lots 244 - 217 Sta 5+08 LF

Location

Kind of Pipe

Size

Size of Main

~~KAPPA~~ New Service


Location

Date	Material	Amount	Total	Date	Amount
8-9-62	Labor	41.79			
	10% O.H.	4.18	45.97		
	16' 6" Transite pipe @.78		12.48		
	4 hrs. Town Shovel @6.50		26.00		
	1 hr. Trucking @3.00		3.00		
	BILL WHEN CONNECTED		87.45		

DATE _____

TOWN OF LEXINGTON — BOARD OF PUBLIC WORKS
SEWER DIVISION

Sketch of Service Here

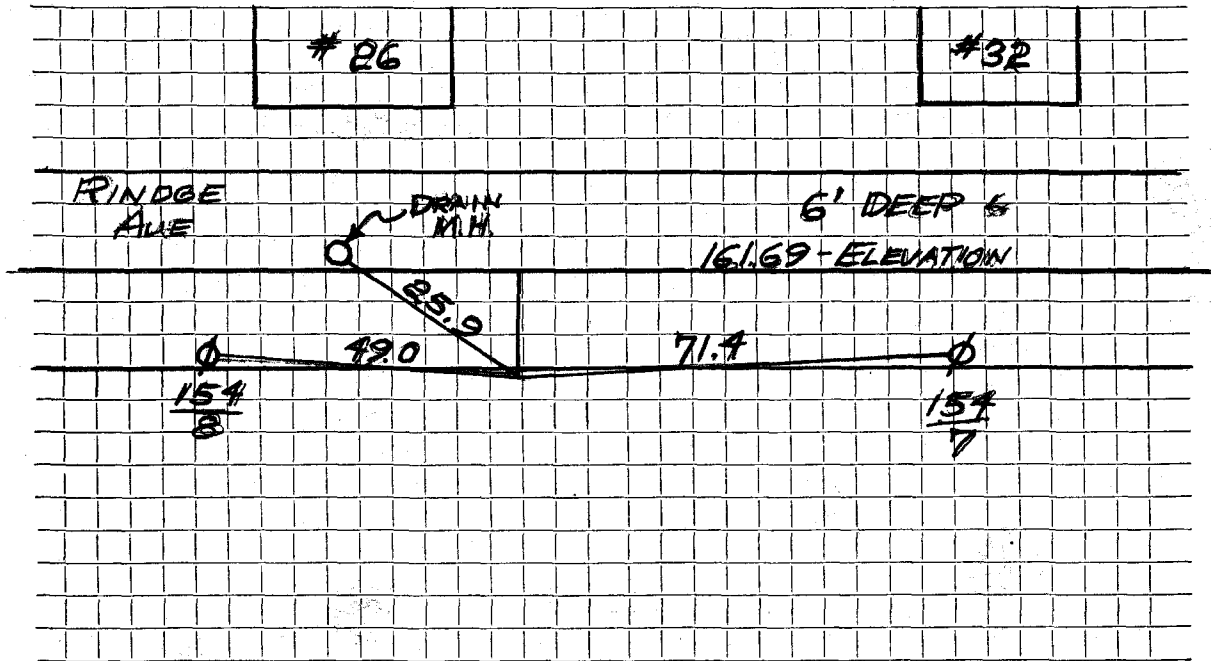

Connection made in Street. Work completed

Remarks:
.....
.....