

Name Thomas A. Sola

Service No. 5

Address 36 Rindge Avenue

36 Rindge Ave. , Conchetta Catello Location

Kind of Pipe

Size 4" Rindge Ave

Size of Main 8"

~~Repair~~ ~~Renewal~~ — New Service COM. 3-21-55

Location

Date	Material	Amount	Total	Date	Amount
2/28/55	Labor	24 92		2-21-55	Deposited 125 00
	10% overhead	2 49	27 41	3-21-55	Refunded (49 01)
	40' - 6" sewer pipe @ .32		12 80		75 99
	1 - 6" elbow		1 88		
	joint compound		2 40		
	4 hrs. Littlefield shovel @ 7.50		30 00		
	2 hrs. trucking @ .75		1 50		
			<u>75 99</u>		
	Labor				

TOWN OF LEXINGTON—DEPT. OF PUBLIC WORKS
SEWER DIVISION

DATE.....

NO.


The undersigned applies for the construction of a particular sewer connecting No.....
Street and hereby agrees to comply with the Rules and Regulations governing the construction and use of Particular
Sewers, as now or at any future time established by the Board of Selectmen.

Am't of estimate \$.....

Am't Paid \$.....

..... Owner

Sketch of Service Here

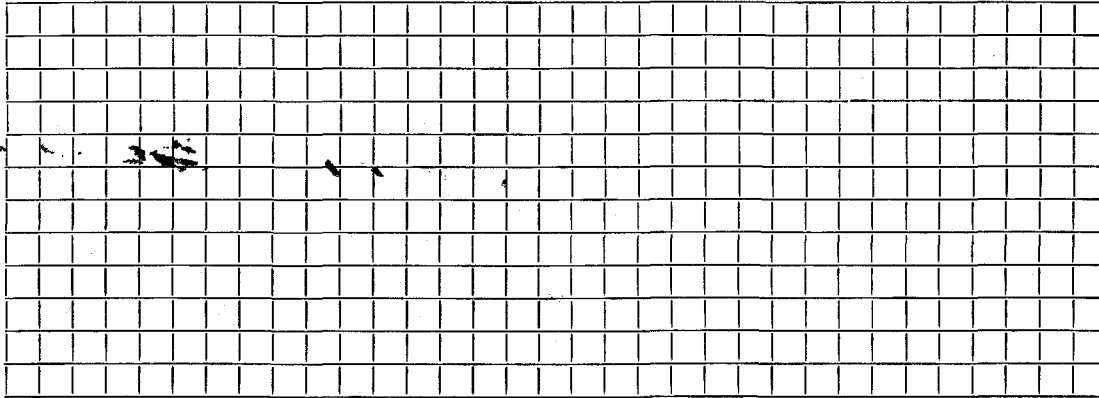

Connection made in..... Street.

Work completed.....19..

Remarks: