

Name **Gabriel Pica**

Service No. 134

Address **5 RINDGE AVE.**

Lot 200-201 Sta 9+60 left **(VACANT LOT)** Location

Kind of Pipe

Size **6"**

Size of Main **8"**

~~Repair~~ ~~Renewal~~ **New Service**

W.O # 8240

Location **Comm 2-10-64**


Date	Material	Amount	Total	Date	Amount
8-13-62	Labor	40.84		10-15-63	200.00
	10% O.H.	4.08	44.92	2-10-64	7.83
	18' 6" Transite pipe @.78		14.04		192.17
	3 hrs. Town Shovel @6.50		19.50		
	1 hr. Trucking @3.00		3.00		
	BILL WHEN CONNECTED		81.46		
10/28/63	Labor	56.59			
	10% O.H.	5.66	62.25		
	28' 6" Transite Pipe @ .82		22.96		
	3 Hrs. Town Shovel @ 6.50		19.50		
	2 Hrs. Trucking @ c.00		6.00		
			192.17		

DATE _____

TOWN OF LEXINGTON — BOARD OF PUBLIC WORKS
SEWER DIVISION

Sketch of Service Here

5

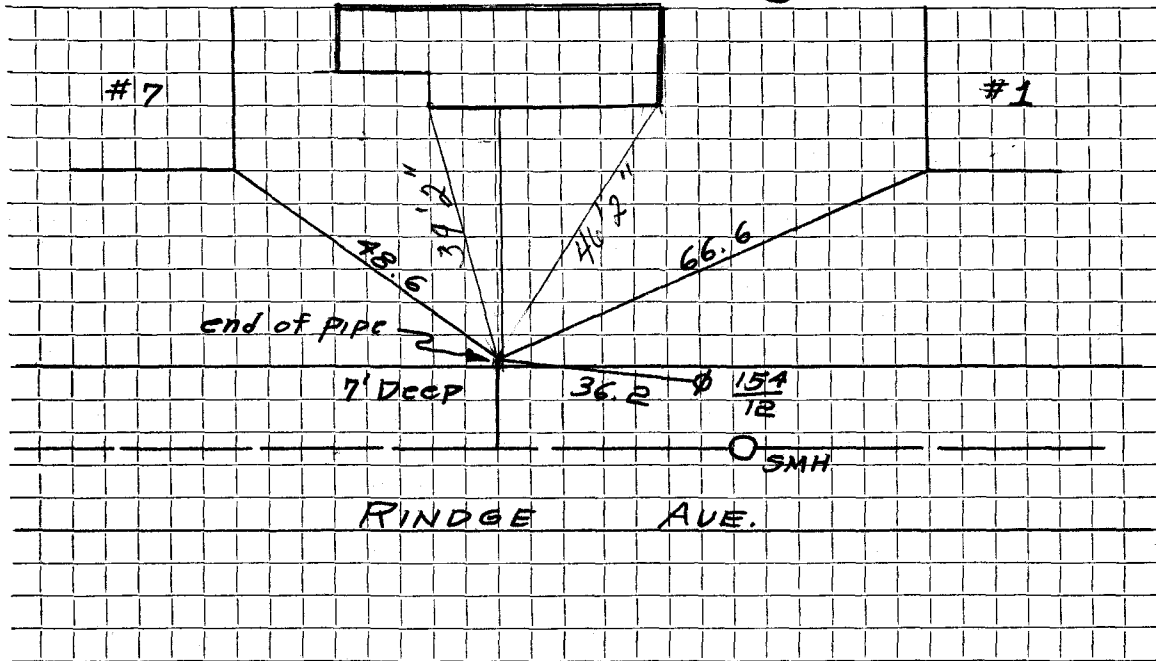

Connection made in Street. Work completed

Remarks:

.....

.....