

Name M. B. Judkins (Builder) Service No. 13 856

Address Grassland St. 11

11 Robbins Rd. Location Douglas Gleason, Lot #85, Robbins Rd.

Kind of Pipe _____ Size 6" Size of Main 8"

~~Repair-Renewal~~ New Service Location _____

Date	Material	Amount	Total	Date	Amount
<u>Jan. 10-27-31</u> <u>for</u> <u>85-27</u>	<u>159' 6" Sewer Pipe @.25</u>	<u>39 75</u>			
	<u>Sulphur & Jute</u>	<u>6 36</u>			
	<u>Trucking</u>	<u>75</u>	<u>46 86</u>	<u>June 30 1931 - Cash</u>	<u>85-27</u>
<u>10/16/31</u>	<u>52 Hrs. Labor @.55</u>	<u>28 60</u>			
	<u>8 " " @.60</u>	<u>4 80</u>	<u>33 40</u>		
	<u>15% Overhead</u>		<u>5 01</u>		
			<u>85 27</u>		
	<u>Labor</u>			<u>11/13/68</u>	<u>Roots</u>
				<u>10-29-69</u>	<u>Roots</u>
				<u>12-11-77</u>	<u>Roots 12' - 15' - 18'</u>

Hadley Press, Inc., Lexington

Water & Sewer in same trench

TOWN OF LEXINGTON - BOARD OF PUBLIC WORKS

SEWER DIVISION (Plan # 12003)

DATE May 15, 1931

NO. _____
Lot


The undersigned applies for the construction of a particular sewer connecting No. #83 Robbins Road Street and hereby agrees to comply with the Rules and Regulations governing the construction and use of Particular Sewers, as now or at any future time established by the Board of Selectmen.

Am't. of Estimate \$ _____

Am't. Paid \$ _____

Douglas Gleason Owner
By M. Bourne Judkins

Sketch of Service Here

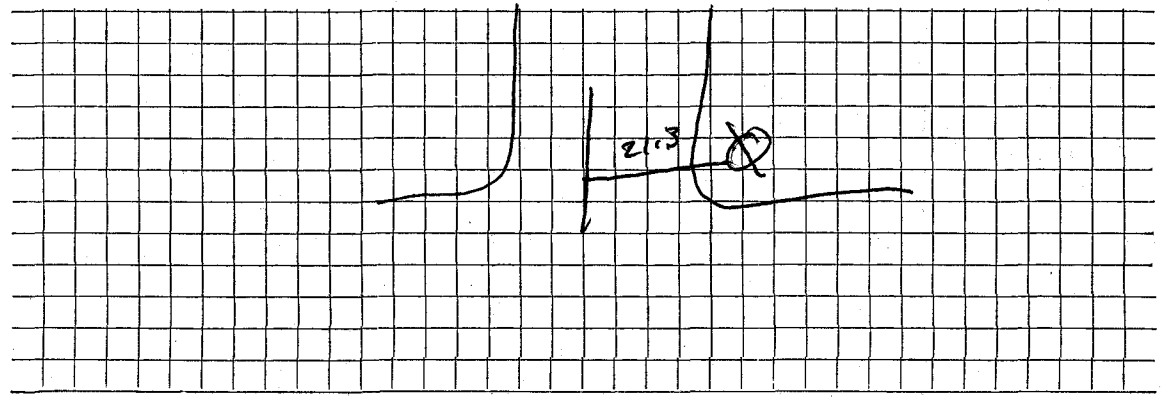

Connection made in _____ Street. Work completed _____ 19

Remarks: Sewer under water line repaired 3/15/07 / Gas line
6' - 6" PVC 2-clay x PVC Aruco