

Address 14 Robbins Road

Location ~~Lot 71~~ *Washington Ave.*

Size of Main

~~x~~ *Revised Estimate - New Service*

Location


Date	Material	Amount	Total	Date	Amount
3/29/38	1 hr. @ 65¢	65		March 7, 1938	63.00
<i>Com 5-10-38</i>	13 3/4 hrs. @ 60¢	8 25			
	38 3/4 " @ 55¢	21 32	30 22.		
	10% Overhead		3 02		
	55' 6" Sewer Pipe @ 20¢		11 00		
	1 6" 1/8 Bend		65		
	1 6" 6 x 4 Reducer		90		
	Jointing Compound		3 36		
	2 hrs. Trucking @ 75¢		1 50		
	6 hrs. Compressor @ 3.00		18 00		
			68 65		
	Flat Rate: \$63.00				
	Labor				

Haley Bros. Inc., Lexington

DATE _____

TOWN OF LEXINGTON — BOARD OF PUBLIC WORKS
SEWER DIVISION

Sketch of Service Here **14**

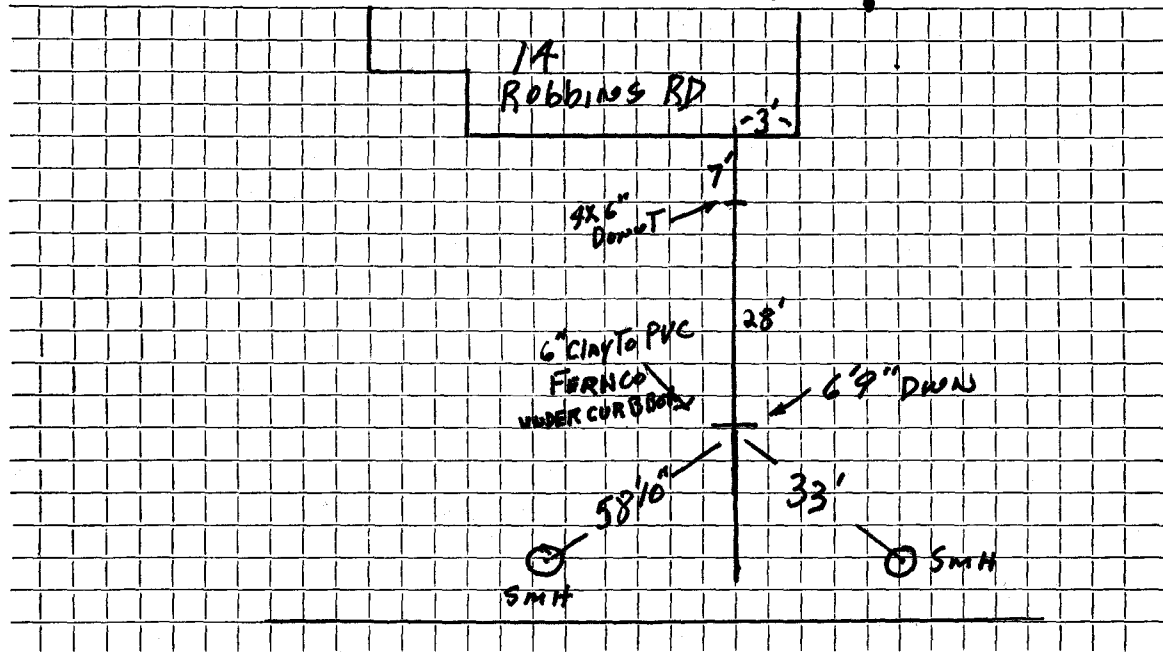

Connection made in Robbins R.D. Street. Work completed

Remarks: FERNCO. IS 2'3" UNDER CURB STOP. Original Service 6-1-31 (43'-6" Sewer Pipe, 10'-4" C.I. Pipe)