

Name Stanley J. Phalen

Service No.

45 860

Address 23 Daniels St., Arlington

21 Robbins Rd.

Location 21 Robbins Road

Kind of Pipe

Size 6"

Size of Main 8"

~~Repair - Renewal~~ - New Service

Location

Date	Material	Amount	Total	Date	Amount
P. 12-30-30 for 13 34	80' 6" Sewer Pipe @.30	\$9 00			
1-27-31 for 71.50	10' 4" Iron " @.50	5 00			
	Sulphur & Jute	1 20		Nov. 25 1930	Cash 13 34
	Trucking	75	\$15 95	Nov 25 1930	Cash 63 32
5/30	98 Hrs. Labor @.55	53 90		Jan 25 1931	Cash 8 12
10	" " @.60	6 00	59 90		84 84
	15% Overhead		8 99		
			84 84		
1-28-34	74' 6" Sewer Pipe				
	Labor				

Haley Press, Inc., Lexington

TOWN OF LEXINGTON—BOARD OF PUBLIC WORKS

SEWER DIVISION

DATE Nov. 25, 1930

NO. _____


The undersigned applies for the construction of a particular sewer connecting No. 21 Robbins Road Street and hereby agrees to comply with the Rules and Regulations governing the construction and use of Particular Sewers, as now or at any future time established by the Board of Selectmen.

Am't. of Estimate \$ _____

Am't. Paid \$ _____

Stanley J. Phalen Owner

Sketch of Service Here

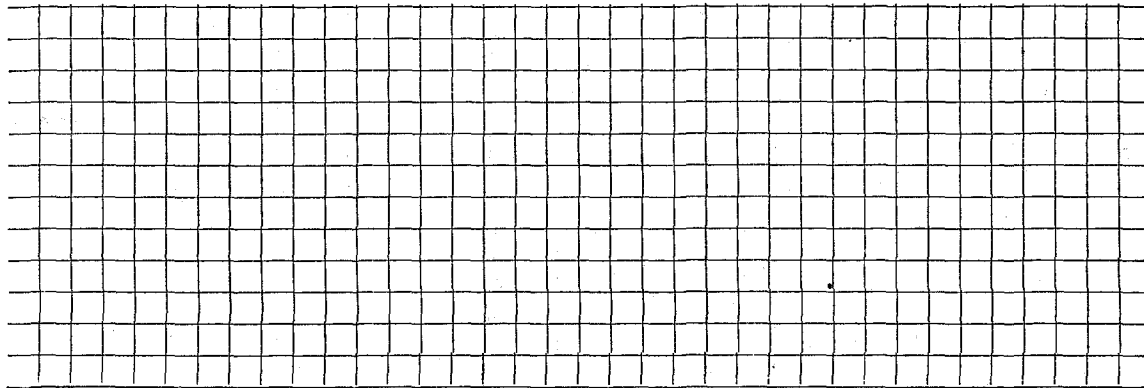

Connection made in _____ Street.

Work completed _____ 19

Remarks: