

Name Claire C. McDonough

Service No. 88

Address 26 Robbins Road

26 Robbins Rd.

Location

Kind of Pipe

Size 6"

Size of Main 8"

~~Repair~~ ~~Renewal~~ ~~New Service~~ W.O. #7416

Location JAN 27 1969


| Date | Material | Amount | Total | Date | Amount |
|---------|------------------------|--------|--------|---------|--------------------------|
| 10/2/68 | Labor | 110 40 | | 9-25-68 | Deposit 200 00 |
| 10/3/68 | " | 15 06 | 125 46 | 1-27-69 | Retrad 8 14 |
| | 10% O.H. | | 12 55 | | Outside 191 84 |
| 20' | Transitepipe @ .88 | | 17 60 | 10/2/68 | Labor 64 40 |
| 4 | Yds. Loam @ 3.50 | | 14 00 | 10/5/68 | " 33 87 |
| 15 | Lbs. Grass seed @ 1.10 | | 16 50 | 15' | Transitepipe .88 13 20 |
| 1/2 | Ton cold patch @ 5.50 | | 2 75 | 1 | 90° El 4 09 |
| 1 | Hr. trucking | | 3 00 | 1 | Bag cement 1 55 |
| | | | 191 86 | 2 | Dozen brick 1 00 |
| | | | | 3 | Hrs. Shovel @ 6.50 19 50 |
| 11-2-76 | 1 4" DOWN T | | | 1 | " Loader 4 00 |
| | 1 6" X 2' NIPPLE | | | 4 | " Trucking @ 3.00 12 00 |
| | 1 6" X 6" NIPPLE | | | 1 | " " 1 50 |
| | | | | 1 | " Roller & Trailer 5 00 |
| | | | | | 160 11 |
| | | | | 8-9-75 | Plugged Sewer |

DATE _____

TOWN OF LEXINGTON — BOARD OF PUBLIC WORKS

SEWER DIVISION

Sketch of Service Here **26**

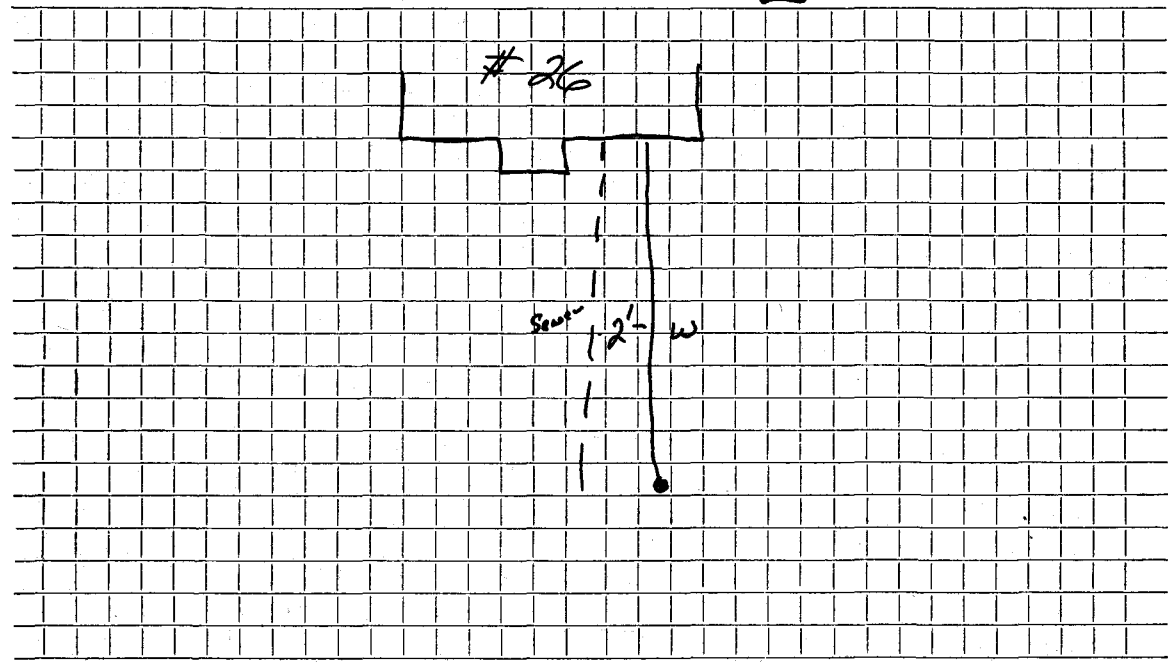

Connection made in Street. Work completed

Remarks: *2' between W/S GAS. ROAD IN ST.*

.....
.....