

Name

Service No.

Address

34 Robbins Road

34 Robbins Rd.

Location

Kind of Pipe

Size 6"

Size of Main 8"

Repair—Renewal—New Service

Location

Date

Material

Amount

Total

Date

Amount

10-23-28

45' 6" Clay Pipe

NON CHARGE

10/7/53

Labor

37 50

10/8/53

Labor

40 75

46'-6" sewer pipe @ .3036

13 97

joint compound

2 76

6 2/3 hrs. Littlefield shovel

@7.50

50 00

2 hrs. trucking

1 50

patching 12 x 3

12 00

158 48

1-24-90

Repair made from sidewalk  
to just inside water main

Labor

6x6 Clay to PVC FERRO

6x6 PVC to PVC FERRO

5"x6" Clay to PVC FERRO

TOWN OF LEXINGTON—DEPT. OF PUBLIC WORKS  
SEWER DIVISION

DATE .....

NO. ....

The undersigned applies for the construction of a particular sewer connecting No. ....  
Street and hereby agrees to comply with the Rules and Regulations governing the construction and use of Particular  
Sewers, as now or at any future time established by the Board of Selectmen.


Am't of estimate \$.....

Am't Paid \$.....

..... Owner

Sketch of Service Here

34

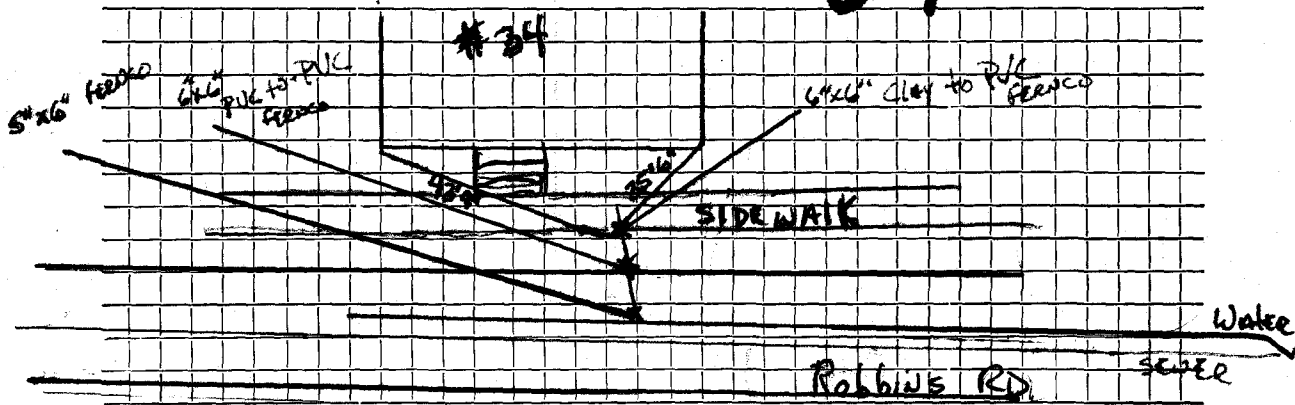

Connection made in ..... Street.

Remarks:

Work completed SERVICES.....19..  
WATER AND SEWERS ARE SIDE BY SIDE  
SEWER ON UP HILL SIDE