

Name Barnhill, F. H.

Service No. 12 866

Address 12 Harvard St., Arlington

35 Robbins Rd.

Location 35 Robbins Road, Lexington

Kind of Pipe

Size 6"

Size of Main 8"

~~Repair-Renewal~~ - New Service

Location

| Date                                     |                         | Material | Amount       | Total        | Date          | Amount |
|--|-------------------------|----------|--------------|--------------|---------------|--------|
| 1936                                     |                         |          |              |              |               |        |
| 7/15                                     | 62 hrs. labor @ 55¢     |          | 34 10        |              | 7-10-36       | 60 00  |
| <small>com. 7-21-36<br/># 57, 55</small> | 19 " " @ 60¢            |          | <u>11 40</u> | 45 50        | July 26, 1936 | 45     |
|  | 10% Ovhd. on labor      |          |              | 4 55         |               | 59 55  |
|  | 45' 6" Sewer Pipe @ 16¢ |          | 7 20         |              |               |        |
|  | Joint. comp.            |          | 80           |              |               |        |
|  | Trucking                |          | <u>1 50</u>  | <u>9 50</u>  |               |        |
|  |                         |          |              | <u>59 55</u> |               |        |
|  | Labor                   |          |              |              |               |        |

Deposited  
funded

Hadley Press, Inc., Lexington

TOWN OF LEXINGTON—BOARD OF PUBLIC WORKS

SEWER DIVISION

DATE June 30, 1936


NO. \_\_\_\_\_

The undersigned applies for the construction of a particular sewer connecting No. 35 Robbins Road Street and hereby agrees to comply with the Rules and Regulations governing the construction and use of Particular Sewers, as now or at any future time established by the Board of Selectmen.

Am't. of Estimate \$ \_\_\_\_\_

Am't. Paid \$ \_\_\_\_\_

F.H. Burnhill Owner

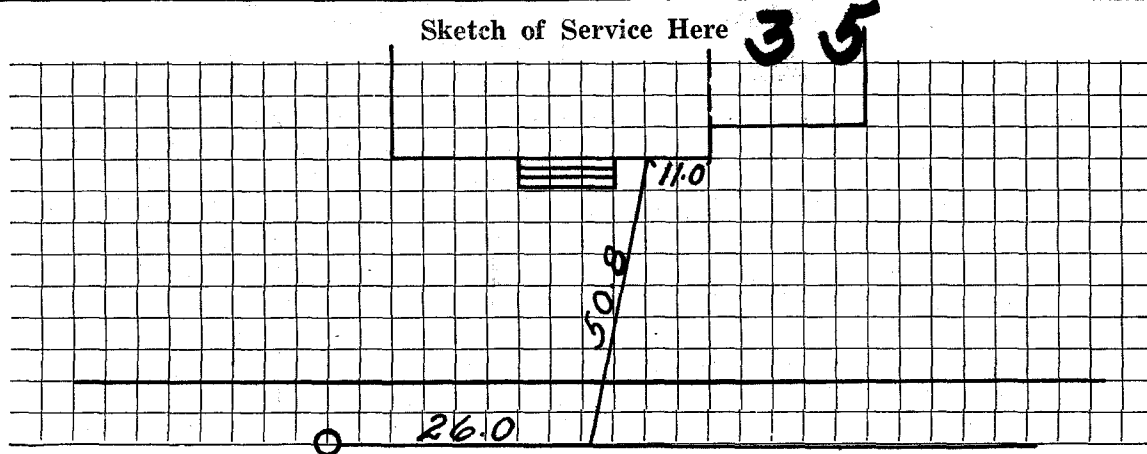

Connection made in \_\_\_\_\_ Street.

Work completed \_\_\_\_\_ 19

Remarks: