

Name ~~None~~ M. Bowman Judkins - (Owner <sup>Mr</sup> Galt.)

Service No. 1937 - #2

Address ~~6 Colony Road~~

4 Robbins Rd.

Location Lot #16 Robbins Road #4

Kind of Pipe

Size 6"

Size of Main 8"

~~Repair~~ ~~Renewal~~ - New Service

Location

Date	Material	Amount	Total	Date	Amount
12-21-'36	119 hrs. @ 55¢	65 45		March 20, 1937 Paid	86 74
<i>Call 3-23-37</i>	10% overhead	<u>6 54</u>	71 99		
	56' 6" Pipe @ 20¢		11 20		
	Jointing Comp.		1 80		
	Trucking		<u>1 75</u>		
			86 74 ✓		
				Bill sent 2-25-37	
	Labor				

Haldy Press, Inc., Lexington

TOWN OF LEXINGTON—BOARD OF PUBLIC WORKS  
SEWER DIVISION

DATE \_\_\_\_\_


NO. \_\_\_\_\_

The undersigned applies for the construction of a particular sewer connecting No. \_\_\_\_\_ Street and hereby agrees to comply with the Rules and Regulations governing the construction and use of Particular Sewers, as now or at any future time established by the Board of Selectmen.

Am't. of Estimate \$ \_\_\_\_\_

Am't. Paid \$ \_\_\_\_\_

\_\_\_\_\_ Owner

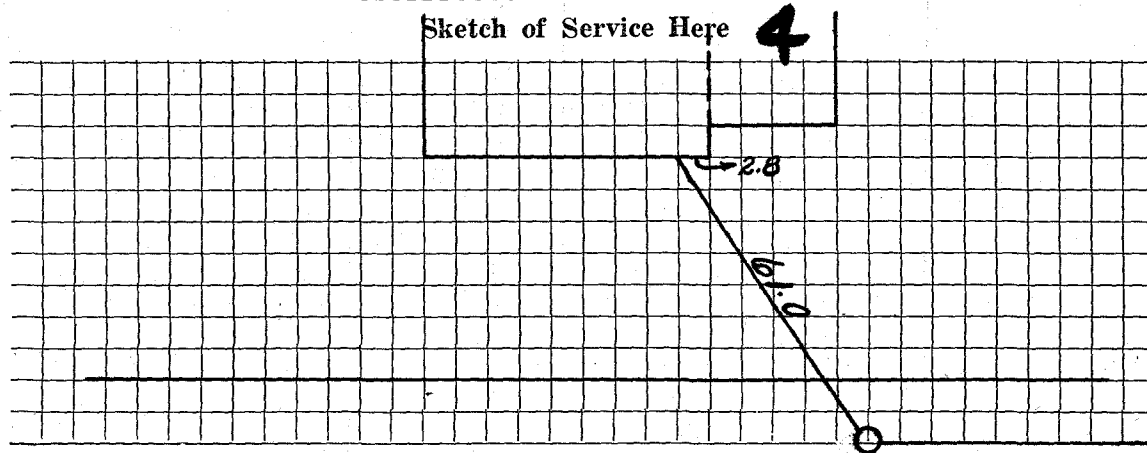

Connection made in \_\_\_\_\_ Street.

Work completed \_\_\_\_\_ 19

Remarks: