




DATE \_\_\_\_\_

TOWN OF LEXINGTON — BOARD OF PUBLIC WORKS

SEWER DIVISION

#49 Robbins Rd.

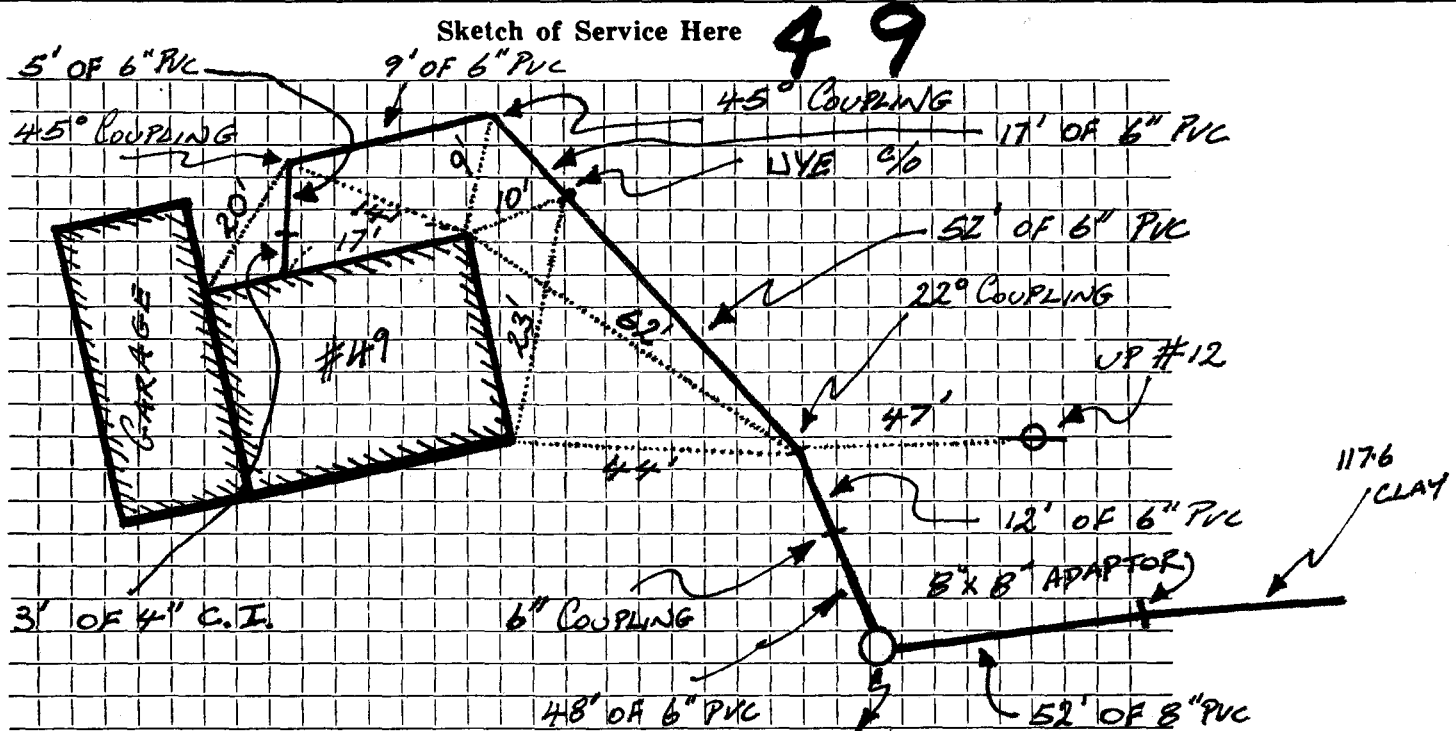

Connection made in Robbins Road Street. Work completed .....

Remarks: .....